

**City of Prince George
HISTORY SHEET**

158151261

SHEET NUMBER

Roll Number

288

Legal: LOT'S 1-2 BLOCK 88 D.L. 937 PLAN 752

Address: 293 EWERT ST.

Sanitary Connection: # 3006 SIZE 100mm MATERIAL A.C. INV. 587.168 CONNECTED

Water Connection # 3158 SIZE 20mm MATERIAL CU. METER CONNECTED

Storm Connection: # SIZE MATERIAL INV. CONNECTED

Cash Receipt No's: WATER SANITARY STORM

CURB FROM PROPERTY LINE 4.877m PAVEMENT WIDTH 10.363m

B.C. HYDRO O/H UNDERGROUND CONNECTION


B.C. TELEPHONE O/H UNDERGROUND CONNECTION

INLAND GAS 1.524m FROM WEST SIDE OF LANE.


Information Sheets:

Comments: WITH THAW WIRE

**THE INFORMATION CONTAINED HEREIN IS FOR INTERNAL USE ONLY.
NOT TO BE RELIED UPON UNLESS CONFIRMED BY SITE INSPECTION AND/OR INVESTIGATION**

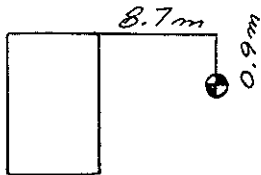

EWERT ST.

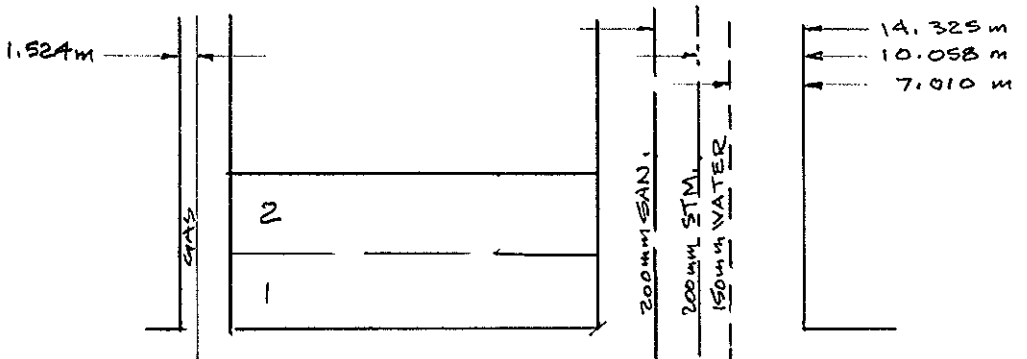

3 RD AVE.

