

City of Prince George HISTORY SHEET

420 HM

SHEET NUMBER

Roll Number

Legal: LOT'S 19-20-21 BLOCK 85 D.L. 937 PLAN 752

Address: 254 IRVIN ST.

Sanitary Connection: # 1925 SIZE 100mm MATERIAL A.C INV. 595.389 CONNECTED

Water Connection # 3111 SIZE 20mm MATERIAL CU METER CONNECTED

Storm Connection: # SIZE MATERIAL INV. CONNECTED

Cash Receipt No's: WATER SANITARY STORM

CURB FROM PROPERTY LINE 4.877m PAVEMENT WIDTH 10.363m


B.C. HYDRO O/H UNDERGROUND CONNECTION

B.C. TELEPHONE O/H UNDERGROUND CONNECTION


INLAND GAS 1.524m FROM R. IN LANE.

Information Sheets:

Comments: WITH THIN WIRE.

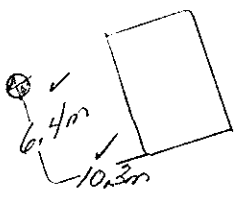

SITE PLAN N.T.S.

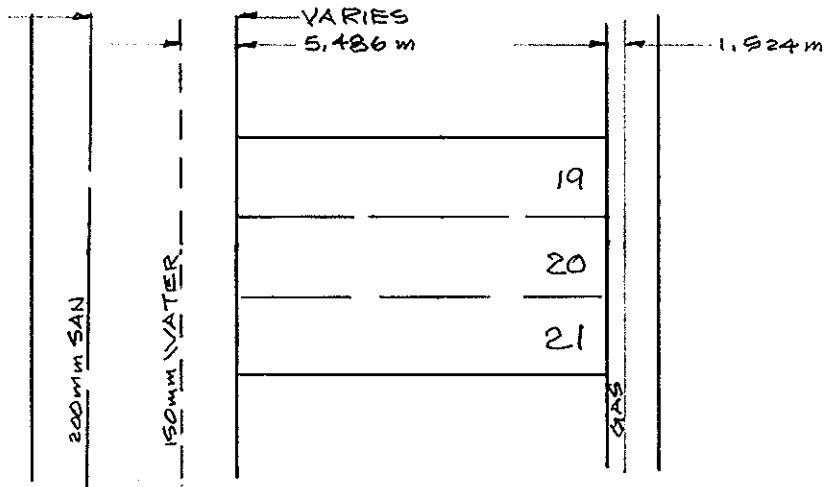

IRVIN ST.

