



City of Prince George

PID:	008161437
PID:	008161488
PID:	008161496
SD/MU:	
WO:	

History Sheet

Civic Address: 258 Freeman St
262 freeman St

Legal Description: Lot: 18 Block: 88 District Lot: 937 Plan: 752
Lot: 19 Block: 88 District Lot: 937 Plan: 752
Lot: 20 Block: 88 District Lot: 937 Plan: 752


Service Type	Diameter (mm)	Material	Invert Elev at main (m)	Invert Elev at property line (m)	Invert Elev at service end (m)	Distance into property (m)	Installation Date
Sanitary	100mm	AC	-	-	-	-	-
Water	20mm	Copper	-	-	-	-	January 1955
Storm	N/A	N/A	-	-	-	-	

Service Connection Location				Sanitary (m)	Storm (m)
Distance from downstream San MH	2523	towards upstream San MH	1639	55.06	
Distance from downstream Stm MH	-	towards upstream Stm MH	-		

Power	Size	Communications	Size	Cable	Size	Gas	Size
BC Hydro	-	Telus	-	Shaw	-	FortisBC	-
Overhead Service		Overhead Service		Overhead Service			

Installed by:		Survey Date:	-
Comments:	Water service locatio confirmed October 2016.		

NOT TO SCALE The information contained herein is for internal use only.
Not to be relied on unless confirmed by site inspection and/or investigation.

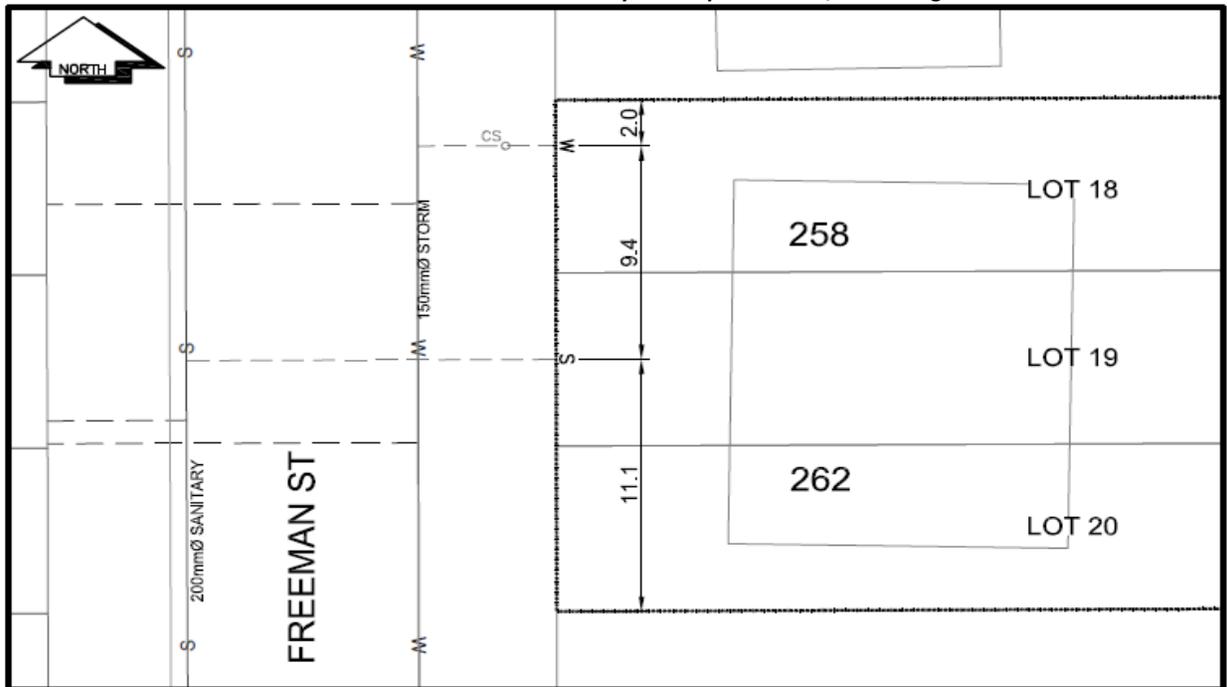

LEGEND:	CS ^o	CURB STOP	---	W	WATER SERVICE	---	D	STORM SERVICE
	CO ^o	CLEAN OUT	---	S	SANITARY SERVICE	---	G	GAS

NOT TO SCALE