

City of Prince George
HISTORY SHEET

682

SHEET NUMBER

Roll Number

Legal: LOT'S **406-407** BLOCK D.L. **936** PLAN **15185**

Address: **873 AHBALU STREET**

Sanitary Connection: # **5343** SIZE **100mm** MATERIAL **ACS.** INV. CONNECTED

Water Connection # **4337** SIZE **40mm** MATERIAL **Cu.** METER CONNECTED

Storm Connection: # SIZE MATERIAL INV. CONNECTED

Cash Receipt No's: WATER **2922** SANITARY **2922** STORM

CURB FROM PROPERTY LINE

PAVEMENT WIDTH

B.C. HYDRO

UNDERGROUND CONNECTION

B.C. TELEPHONE


UNDERGROUND CONNECTION

INLAND GAS

Information Sheets:

Comments:

THE INFORMATION CONTAINED HEREIN IS FOR INTERNAL USE ONLY.
NOT TO BE RELIED UPON UNLESS CONFIRMED BY SITE INSPECTION AND/OR INVESTIGATION

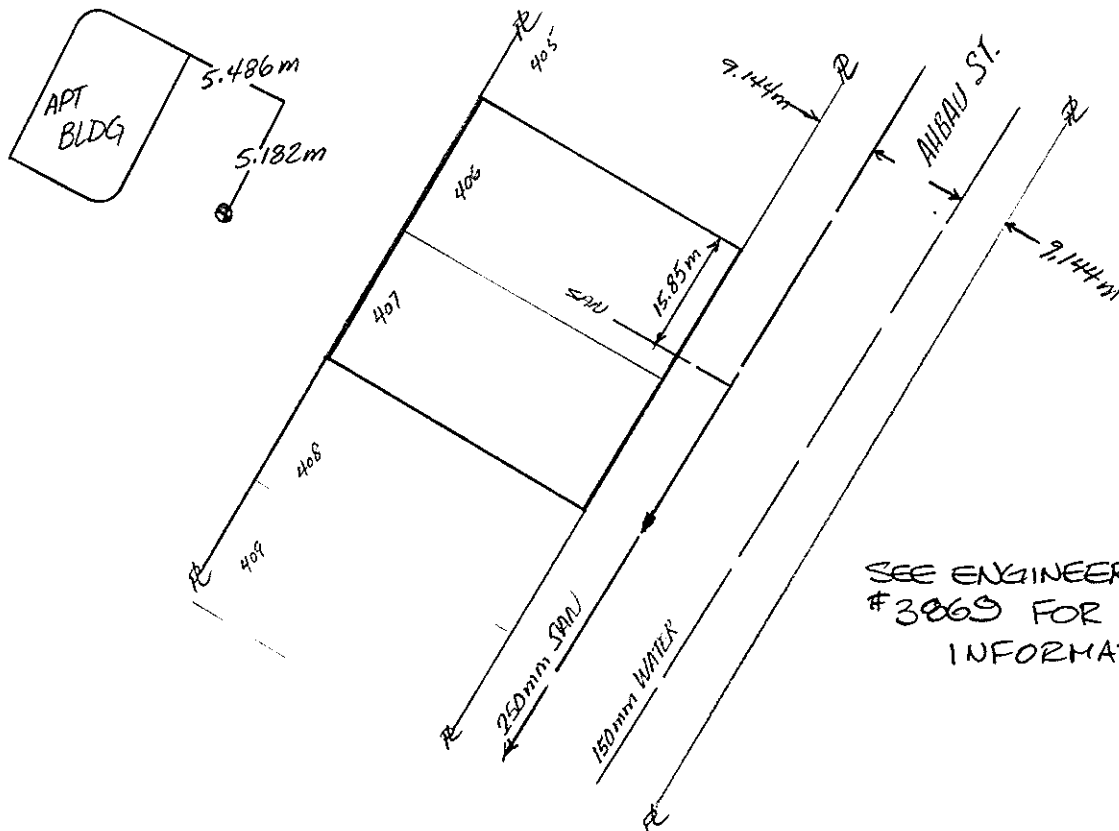

SEE ENGINEER DRAWING
#3869 FOR CONNECTION
INFORMATION