

City of Prince George
HISTORY SHEET

001016
909

SHEET NUMBER

Roll Number

Legal: LOT'S 404-405 BLOCK D.L. 936 PLAN 15185

Address: 835 AHBAY STREET

Sanitary Connection: # 5342 SIZE 100mm MATERIAL ACS. INV. CONNECTED

Water Connection # 4336 SIZE 40mm MATERIAL Cu METER CONNECTED

Storm Connection: # SIZE MATERIAL INV. CONNECTED

Cash Receipt No's: WATER 2922 SANITARY 2922 STORM

CURB FROM PROPERTY LINE

PAVEMENT WIDTH

B.C. HYDRO UNDERGROUND CONNECTION


B.C. TELEPHONE UNDERGROUND CONNECTION

INLAND GAS

Information Sheets:

Comments:

THE INFORMATION CONTAINED HEREIN IS FOR INTERNAL USE ONLY.
NOT TO BE RELIED UPON UNLESS CONFIRMED BY SITE INSPECTION AND/OR INVESTIGATION

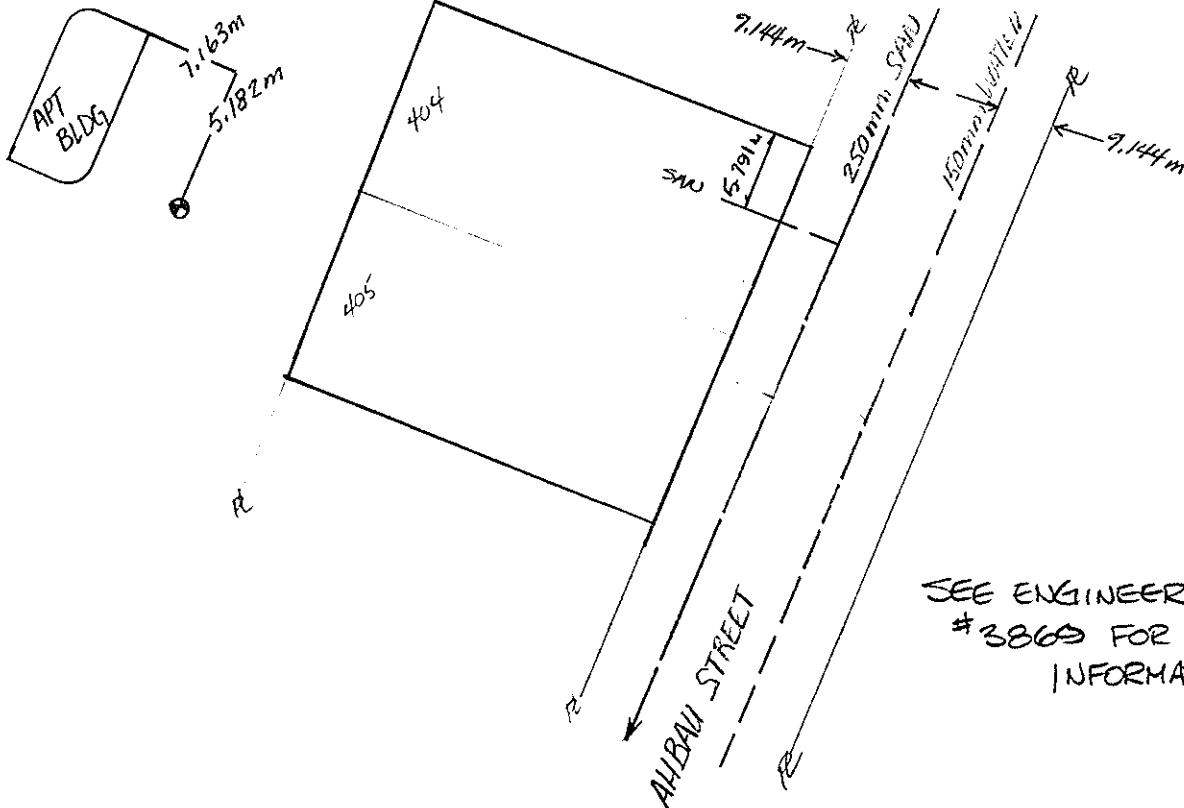

SEE ENGINEER DRAWING
#3865 FOR CONNECTION
INFORMATION.