

**City of Prince George  
HISTORY SHEET**

682

SHEET NUMBER

Roll Number

Legal: LOT'S **406-407** BLOCK D.L. **936** PLAN **15185**

Address: **873 AHBAU STREET**

Sanitary Connection: # **5343** SIZE **100mm** MATERIAL **ACS** INV. CONNECTED

Water Connection # **4337** SIZE **40mm** MATERIAL **Cu.** METER CONNECTED

Storm Connection: # SIZE MATERIAL INV. CONNECTED

Cash Receipt No's: WATER **2922** SANITARY **2922** STORM

CURB FROM PROPERTY LINE PAVEMENT WIDTH

B.C. HYDRO UNDERGROUND CONNECTION


B.C. TELEPHONE UNDERGROUND CONNECTION

INLAND GAS

Information Sheets:

Comments:

**THE INFORMATION CONTAINED HEREIN IS FOR INTERNAL USE ONLY.  
NOT TO BE RELIED UPON UNLESS CONFIRMED BY SITE INSPECTION AND/OR INVESTIGATION**

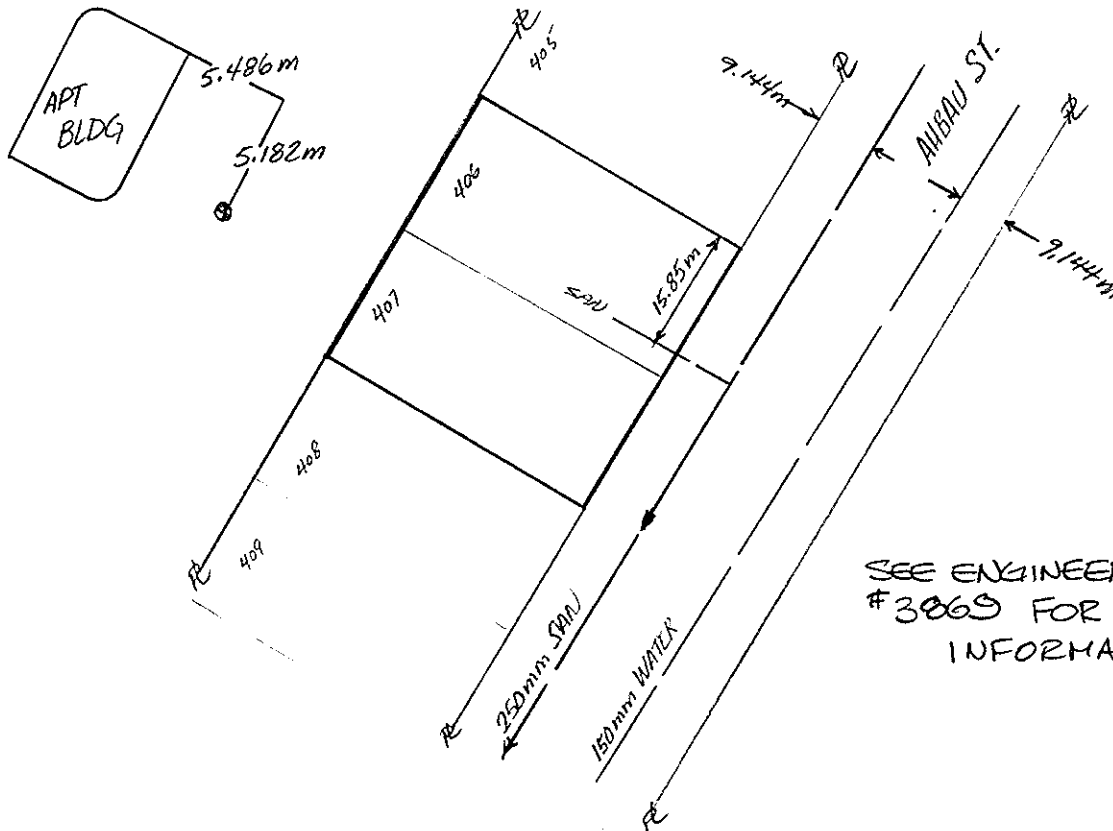

SEE ENGINEER DRAWING  
# 3069 FOR CONNECTION  
INFORMATION