

**City of Prince George
HISTORY SHEET**

008178283

SHEET NUMBER

Roll Number

291

Legal: LOT'S 19-20 BLOCK 99 D.L. 937 PLAN 752

Address: 158 KELLY ST.

Sanitary Connection: # 3434 SIZE 100 MM MATERIAL A.C. INV. 597.184 CONNECTED

Water Connection # 3396 SIZE 20 MM MATERIAL CU. METER CONNECTED

Storm Connection: # SIZE MATERIAL INV. CONNECTED

Cash Receipt No's: WATER SANITARY STORM

CURB FROM PROPERTY LINE 4.877 m PAVEMENT WIDTH 10.363


B.C. HYDRO 0/H UNDERGROUND CONNECTION

B.C. TELEPHONE 0/H UNDERGROUND CONNECTION


INLAND GAS 1.524 m FROM P. IN LANE

Information Sheets:

Comments: WITH THAW WIRE.

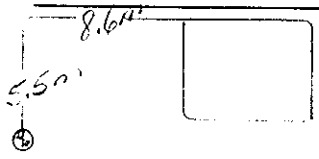

SITE PLAN N.T.S.

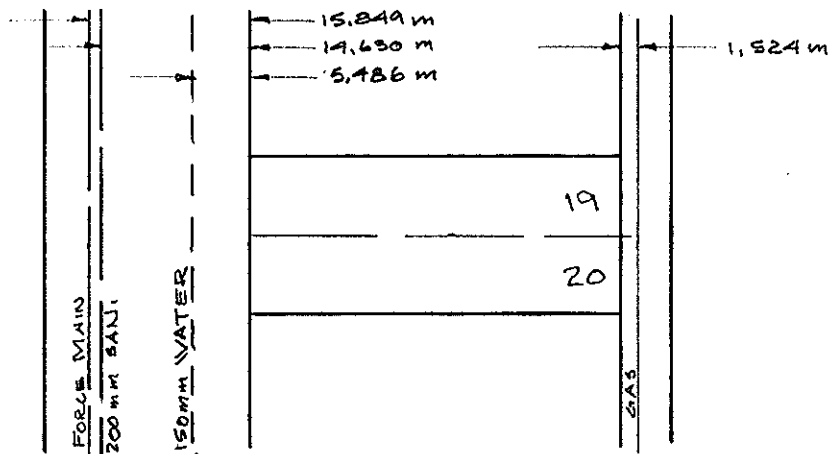

KELLY ST.