

**City of Prince George  
HISTORY SHEET**

008178313

SHEET NUMBER

Roll Number

330

Legal: LOT'S 23-24 BLOCK 99 D.L. 937 PLAN 752

Address: 190 KELLY ST.

Sanitary Connection: # 3089 SIZE 100mm MATERIAL A.C. INV. 596.968 CONNECTED

Water Connection # 3208 SIZE 20mm MATERIAL C.U. METER CONNECTED

Storm Connection: # SIZE MATERIAL INV. CONNECTED

Cash Receipt No's: WATER SANITARY STORM

CURB FROM PROPERTY LINE 4.877m PAVEMENT WIDTH 10.363


B.C. HYDRO O/H UNDERGROUND CONNECTION

B.C. TELEPHONE O/H UNDERGROUND CONNECTION



INLAND GAS 1.524m FROM R IN LANE.

Information Sheets:

Comments: WITH THAW WIRE.

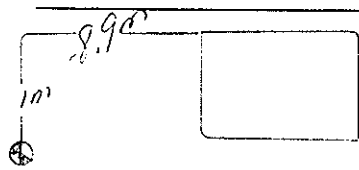

SITE PLAN N.T.S.

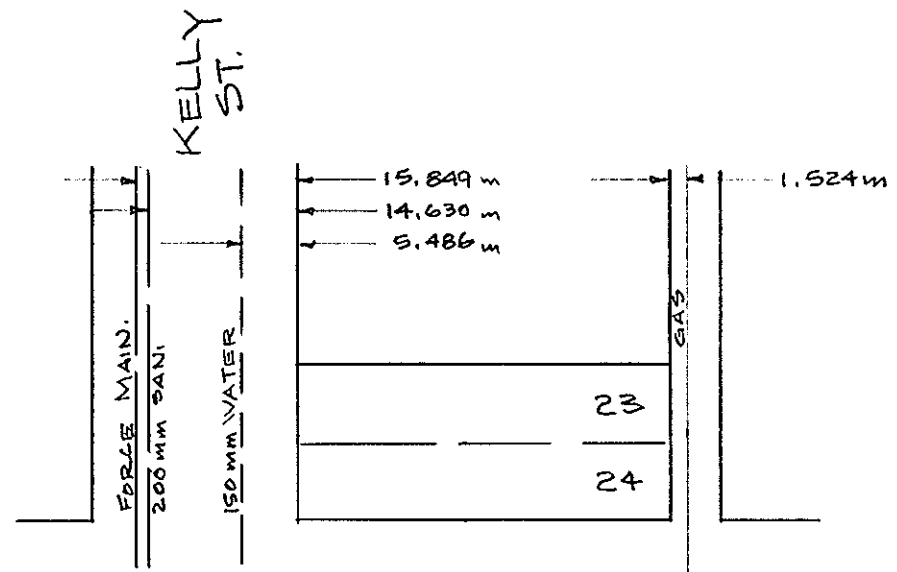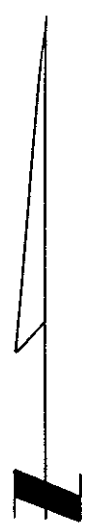

2nd AVE.