

City of Prince George HISTORY SHEET

008198704

SHEET NUMBER _____ Roll Number 712

Legal: LOT'S 19-20 BLOCK 100 D.L. 937 PLAN 752.

Address: 150 LYON ST.

Sanitary Connection: # 5958 SIZE 100 mm MATERIAL A.C. INV. 596.895 CONNECTED

Water Connection # 3135 SIZE 20 mm MATERIAL LU. METER _____ CONNECTED

Storm Connection: # _____ SIZE _____ MATERIAL _____ INV. _____ CONNECTED

Cash Receipt No's: WATER _____ SANITARY _____ STORM _____

CURB FROM PROPERTY LINE 4.877 m PAVEMENT WIDTH 10.363 m


B.C. HYDRO 0/H UNDERGROUND CONNECTION _____

B.C. TELEPHONE 0/H UNDERGROUND CONNECTION _____

INLAND GAS 1.524 m FROM R IN LANE

Information Sheets: _____

Comments: WITH THAW WIRE.

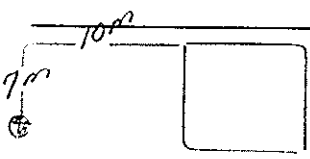

SITE PLAN N.T.S.

