

**City of Prince George  
HISTORY SHEET**

308198721

SHEET NUMBER \_\_\_\_\_ Roll Number 747

Legal: LOT'S 17-18 BLOCK 100 D.L. 937 PLAN 752

Address: 136 LYON ST

Sanitary Connection: # 6050 SIZE 100 mm MATERIAL A.C. INV. 597.620 CONNECTED

Water Connection # 3191 SIZE 20 mm MATERIAL CU METER \_\_\_\_\_ CONNECTED

Storm Connection: # \_\_\_\_\_ SIZE \_\_\_\_\_ MATERIAL \_\_\_\_\_ INV. \_\_\_\_\_ CONNECTED

Cash Receipt No's: WATER \_\_\_\_\_ SANITARY \_\_\_\_\_ STORM \_\_\_\_\_

CURB FROM PROPERTY LINE 4.877 m PAVEMENT WIDTH 10.363 m


B.C. HYDRO 0/H UNDERGROUND CONNECTION \_\_\_\_\_

B.C. TELEPHONE 0/H UNDERGROUND CONNECTION \_\_\_\_\_


INLAND GAS 1.524 m FROM R IN LANE.

**Information Sheets:**

Comments: WITH THAW WIRE.

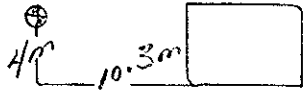

SITE PLAN N.T.S.

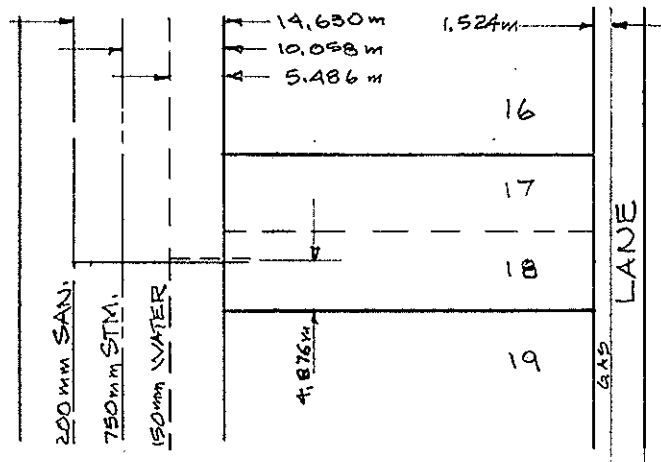

LYON ST.