

**City of Prince George
HISTORY SHEET**

308178721

SHEET NUMBER

Roll Number

747

Legal: LOT'S 17-18 BLOCK 100 D.L. 937 PLAN 752

Address: 136 LYON ST.

Sanitary Connection: # 6050 SIZE 100 mm MATERIAL A.C. INV. 597.620 CONNECTED

Water Connection # 3191 SIZE 20 mm MATERIAL CU METER CONNECTED

Storm Connection: # _____ SIZE _____ MATERIAL _____ INV. _____ CONNECTED

Cash Receipt No's: WATER _____ SANITARY _____ STORM _____

CURB FROM PROPERTY LINE 4.877 m PAVEMENT WIDTH 10.363 m


B.C. HYDRO 0/H UNDERGROUND CONNECTION _____

B.C. TELEPHONE 0/H UNDERGROUND CONNECTION _____

INLAND GAS 1.524 m FROM R IN LANE.

Information Sheets:

Comments: WITH TRAW WIRE.

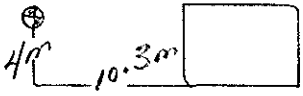

SITE PLAN N.T.S.

