

**City of Prince George
HISTORY SHEET**

008/78755

SHEET NUMBER

Roll Number

763

Legal: LOT'S 21-22 BLOCK 100 D.L. 937 PLAN 752

Address: 166 LYON ST.

Sanitary Connection: # 2715 SIZE 100mm MATERIAL A.C. INV. 596.855 CONNECTED

Water Connection # 3180 SIZE 20mm MATERIAL CU. METER CONNECTED

Storm Connection: # SIZE MATERIAL INV. CONNECTED

Cash Receipt No's: WATER SANITARY 3434 STORM

CURB FROM PROPERTY LINE 4.877 m PAVEMENT WIDTH 10.363 m


B.C. HYDRO O/H UNDERGROUND CONNECTION

B.C. TELEPHONE O/H UNDERGROUND CONNECTION


INLAND GAS 1.524m FROM R IN LANE

Information Sheets:

Comments: WITH THAW WIRE.

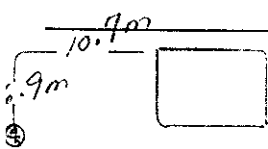

SITE PLAN N.T.S.

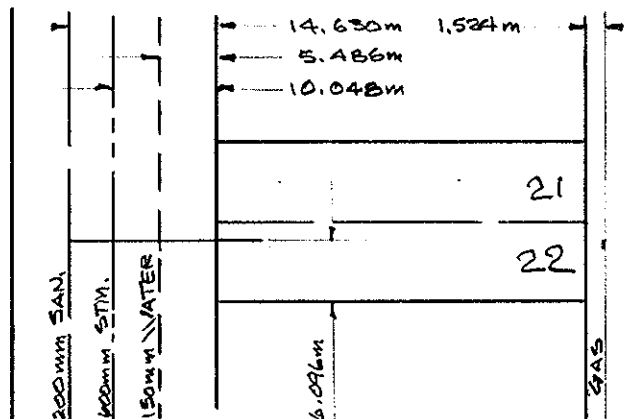

LYON ST.

