

**City of Prince George
HISTORY SHEET**

008/92782

804

SHEET NUMBER

Roll Number

Legal: LOT'S 10-11 BLOCK 102 D.L. 937 PLAN 752

Address: 117 MOFFAT ST.

Sanitary Connection: # 3131 SIZE 100 MM MATERIAL A.C. INV. 602.274 CONNECTED

Water Connection # 3242 SIZE 20 MM MATERIAL C.U. METER CONNECTED

Storm Connection: # SIZE MATERIAL INV. CONNECTED

Cash Receipt No's: WATER SANITARY STORM

CURB FROM PROPERTY LINE 4.877 m PAVEMENT WIDTH 10.363 m


B.C. HYDRO 0/H UNDERGROUND CONNECTION

B.C. TELEPHONE 0/H UNDERGROUND CONNECTION


INLAND GAS 1.524 m FROM WEST SIDE OF LANE.

Information Sheets:

Comments: WITH THAW WIRE.

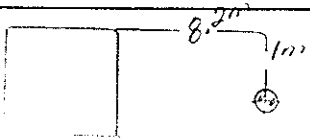

SITE PLAN N.T.S.

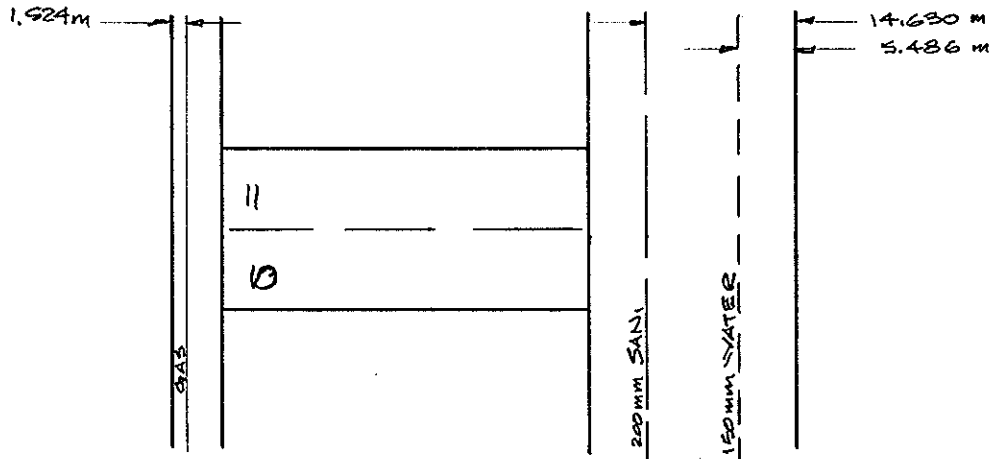

MOFFAT ST.

