

**City of Prince George
HISTORY SHEET**

508177 112
130
156

SHEET NUMBER

Roll Number

Legal: LOT'S 16-17-18 BLOCK 102 D.L. 937 PLAN 752

Address: 140 N. NICHOLSON AVE.

Sanitary Connection: # 3289 SIZE 100 mm MATERIAL A.C. INV. 602.835 CONNECTED

Water Connection # 3323 SIZE 20 mm MATERIAL C.U. METER CONNECTED

Storm Connection: # SIZE MATERIAL INV. CONNECTED

Cash Receipt No's: WATER SANITARY STORM

CURB FROM PROPERTY LINE 4.877 m PAVEMENT WIDTH 10.363 m


B.C. HYDRO 0/4 UNDERGROUND CONNECTION

B.C. TELEPHONE 0/4 UNDERGROUND CONNECTION


INLAND GAS 1.524 m FROM R IN LANE.

Information Sheets:

Comments:

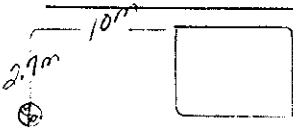

SITE PLAN N.T.S.

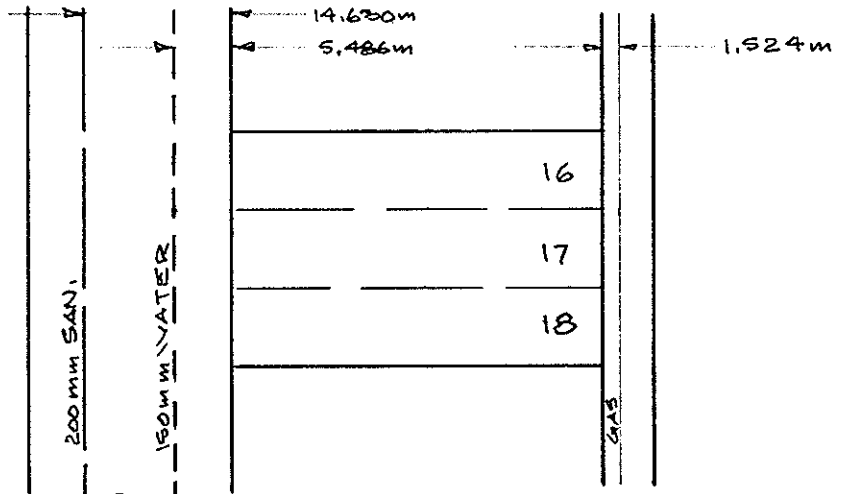

N. NICHOLSON ST.

