



City of Prince George
History Sheet

PID:	008208361
SD/MU:	
WO:	

Civic Address: 2755 Michener Cres

Legal Description: Lot: 12 District Lot: 8175 Plan: 17631


Service Type	Diameter (mm)	Material	Invert Elev at main (m)	Invert Elev at property line (m)	Invert Elev at service end (m)	Distance into property (m)	Installation Date
Sanitary	100mm	PVC	-	589.84	2.60	-	December 1966
Water	20mm	Copper	-	-	-	-	December 1966
Storm	N/A	N/A	-	-	-	-	

Service Connection Location				Sanitary (m)	Storm (m)
Distance from downstream San MH	3832	towards upstream San MH	3833	14.74	
Distance from downstream Stm MH	-	towards upstream Stm MH	-		

Power	Size	Communications	Size	Cable	Size	Gas	Size
BC Hydro	-	Telus	-	Shaw	-	FortisBC	-
Underground Service		Underground Service		Underground Service			

Installed by:		Survey Date:	-
Comments:	Water service located July 2017		

NOT TO SCALE The information contained herein is for internal use only.
Not to be relied on unless confirmed by site inspection and/or investigation.

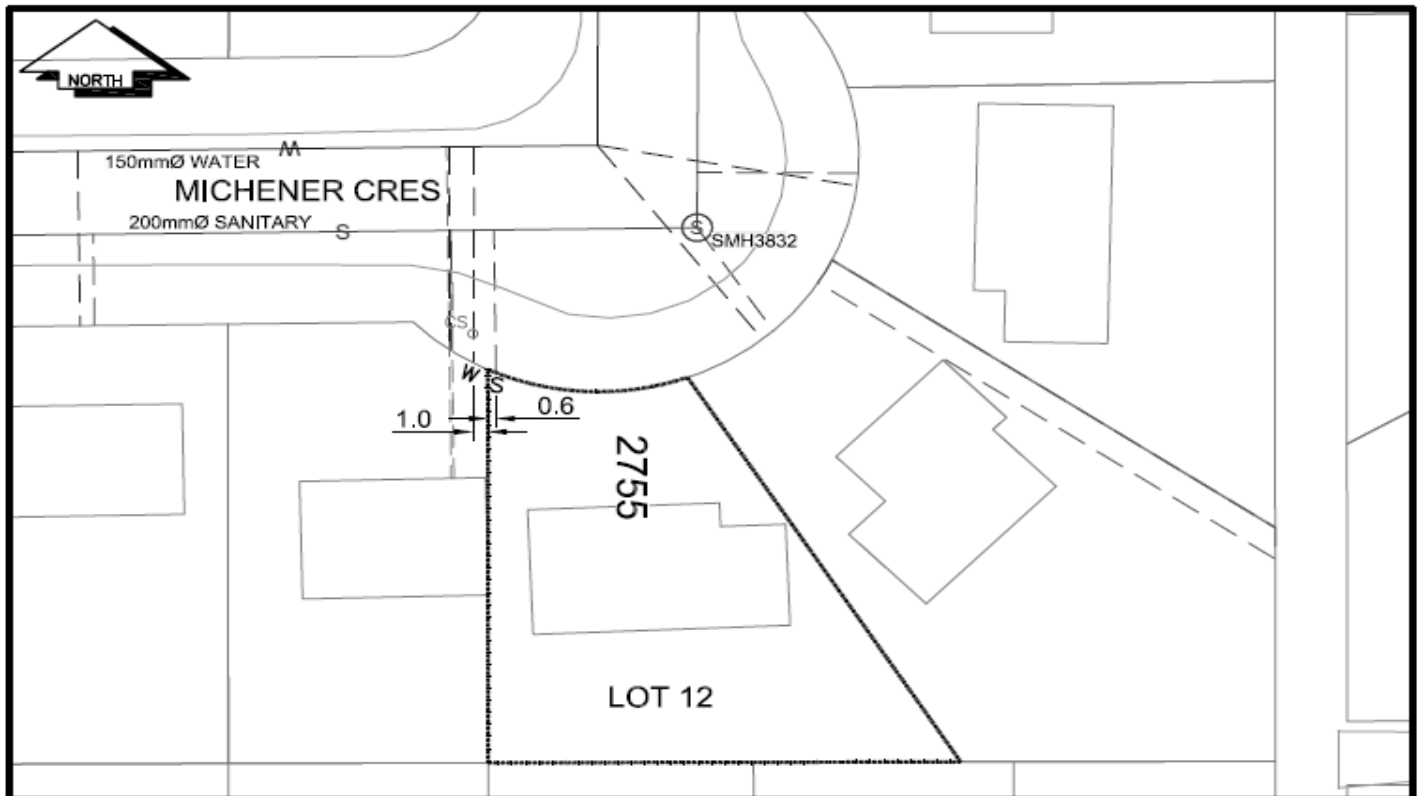

LEGEND:	CURB STOP	WATER SERVICE	STORM SERVICE
	CLEAN OUT	SANITARY SERVICE	GAS
	WATER VALVE	FIRE HYDRANT	ENCUMBRANCE

NOT TO SCALE