



City of Prince George
History Sheet

PID:	008252653
SD/MU:	
WO:	5001720

Civic Address: 2893 Ridgeview Dr
 Legal Description: Lot: 38 District Lot: 4046 Plan: 24376


Service Type	Diameter (mm)	Material	Invert Elev at main (m)	Invert Elev at property line (m)	Invert Elev at service end (m)	Distance into property (m)	Installation Date
Sanitary	100mm	PVC	-	-	-	-	January 1978
Water	20mm	Copper	-	741.13	-	-	January 1972
Storm	N/A	N/A	-	-	-	-	

Service Connection Location	Sanitary (m)	Storm (m)
100mm Sanitary service connected to San MH1277	-	
Distance from downstream Stm MH - towards upstream Stm MH -		

Power	Size	Communications	Size	Cable	Size	Gas	Size
BC Hydro	-	Telus	-	Shaw	-	FortisBC	-
Overhead Service		Overhead Service		Overhead Service			

Installed by:	Survey Date:	-
Comments: Maintenance completed on water service on June 21 2016.		

NOT TO SCALE The information contained herein is for internal use only.
 Not to be relied on unless confirmed by site inspection and/or investigation.

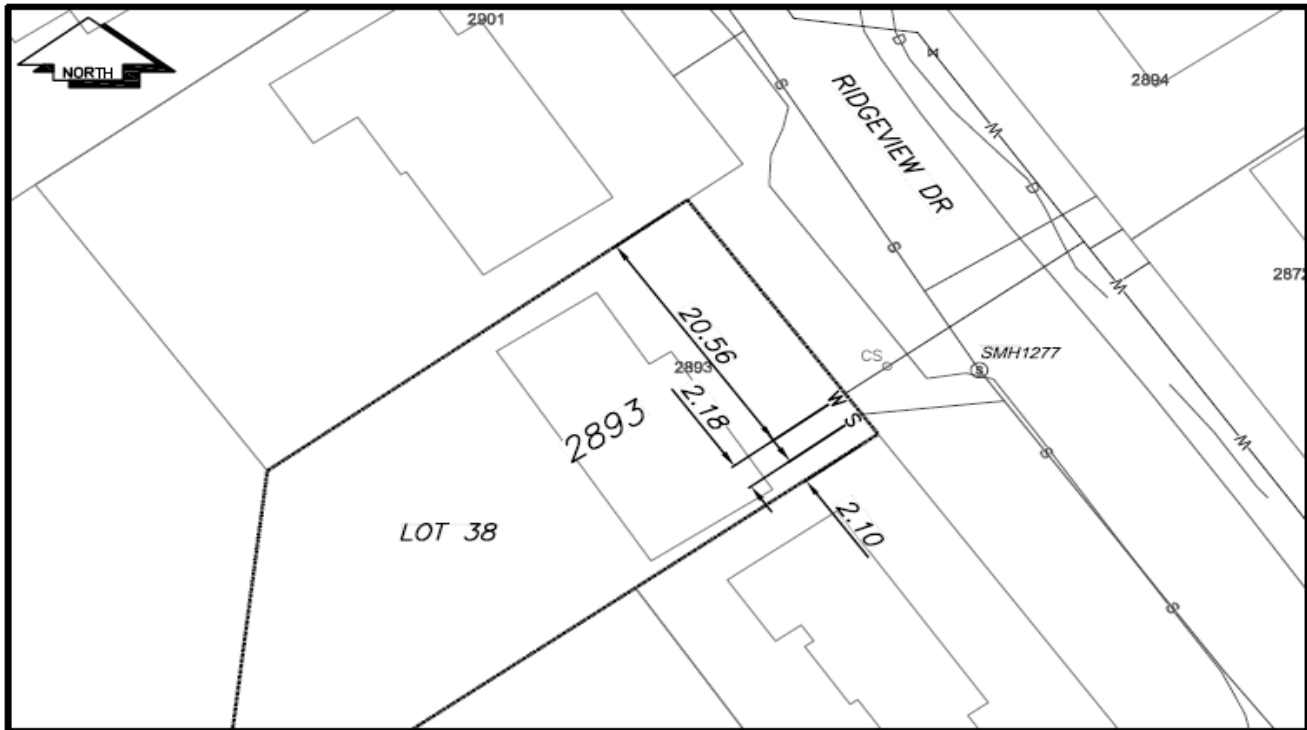

LEGEND:	
CS	CURB STOP
CO	CLEAN OUT
⊗	WATER VALVE
—	WATER SERVICE
- - -	SANITARY SERVICE
⊕	FIRE HYDRANT
—	STORM SERVICE
-G-	GAS
- - -	ENCUMBRANCE

NOT TO SCALE