

**City of Prince George
HISTORY SHEET**

008252661

SHEET NUMBER **1991** Roll Number

Legal: LOT'S **29** BLOCK **SW 1/4** D.L. **4046** PLAN **24376**

Address: **2828 Mc Kenney Cres.**

Sanitary Connection: # SIZE **100 mm** MATERIAL **PVC** INV. **37.55'** CONNECTED

Water Connection # SIZE **19 mm** MATERIAL **Cu** METER CONNECTED

Storm Connection: # **None** SIZE MATERIAL INV. CONNECTED

Cash Receipt No's: WATER SANITARY STORM

CURB FROM PROPERTY LINE **Ditch** PAVEMENT WIDTH **8 m**

B.C. HYDRO UNDERGROUND CONNECTION


B.C. TELEPHONE UNDERGROUND CONNECTION

INLAND GAS

THE INFORMATION CONTAINED HEREIN IS FOR INTERNAL
USE ONLY. NOT TO BE RELIED UPON UNLESS CONFIRMED
BY SITE INSPECTION AND/OR INVESTIGATION.

Information Sheets:

Comments: **Bench Mark** **Elev 743.713**
Hyd. S. N.E. Corner **Ridgeway & Nixon**

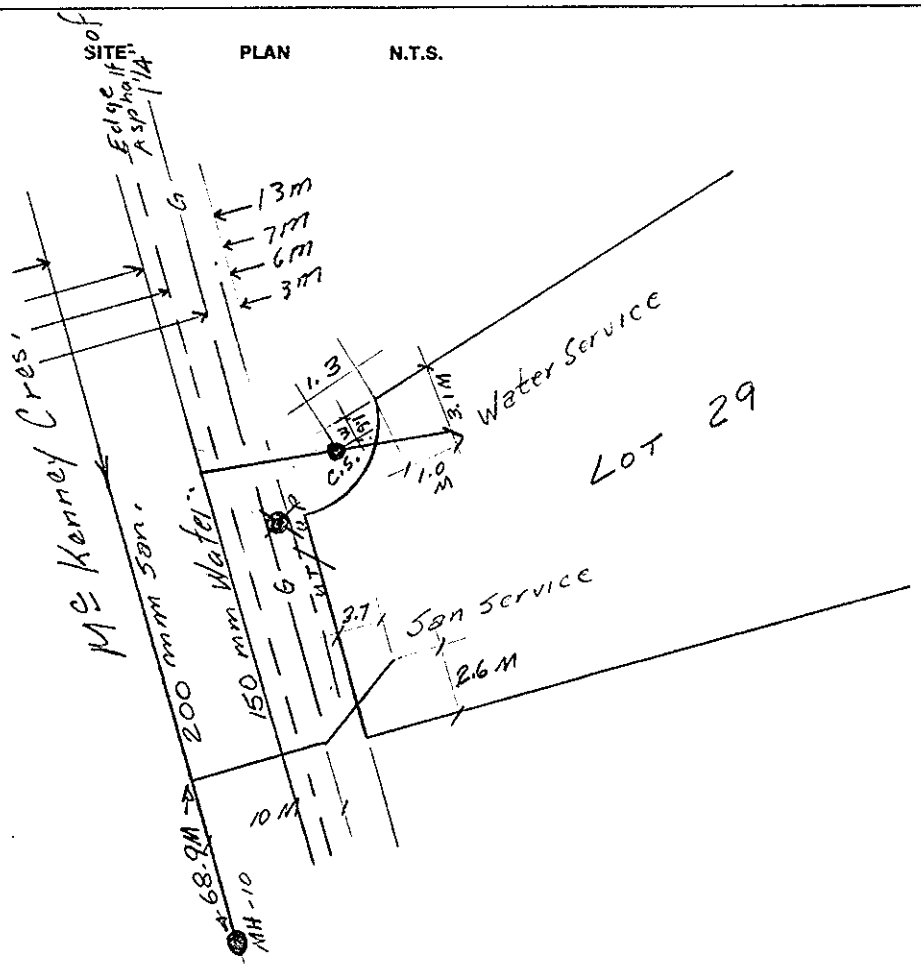

REPORT TO RECORDS

WATER SERVICE INFORMATION

Lot No. _____ Block _____ D.L. _____


Address 2828 MCKENNEY

Size of Connection 1/2" 3/4" Other _____

Type of Connection Copper Iron

Thaw Wire Yes No

LOCATION SKETCH

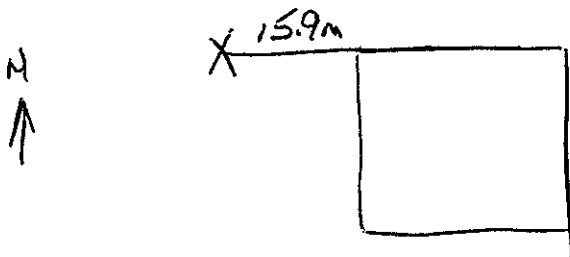

Field Location By L. Pardo Date July 7/95

Checked by: _____


REPORT TO RECORDS

SEWER SERVICE INFORMATION

Lot No. _____ Block _____ D.L. _____

Address 2828 M^cKENNEYSize of Connection 100mm 150mm 200mm Other _____Type of Connection Transite PVC Other _____Type of Cap Transite Cast Iron

LOCATION SKETCH

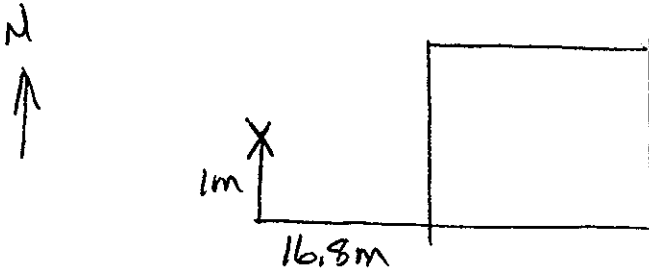Field Location By J. Panko Date July 7/95

Checked by Foreman - Sewer Division _____