

**City of Prince George
HISTORY SHEET**

008 274177 FM

SHEET NUMBER

Roll Number

Legal: LOT'S 208 BLOCK — D.L. 482 PLAN 20916

Address: 4408 URQUHART CRES.

Sanitary Connection: # 8694 SIZE 100mm MATERIAL A.C INV. CONNECTED

Water Connection # 8694 SIZE 20mm MATERIAL COPPER METER CONNECTED

Storm Connection: # SIZE MATERIAL INV. CONNECTED

Cash Receipt No's: WATER SANITARY STORM

CURB FROM PROPERTY LINE 4.877m PAVEMENT WIDTH 0.363m

B.C. HYDRO U/G UNDERGROUND CONNECTION



B.C. TELEPHONE U/G UNDERGROUND CONNECTION

INLAND GAS AS SHOWN

Information Sheets:

Comments: WITH THAW WIRE

**THE INFORMATION CONTAINED HEREIN IS FOR INTERNAL USE ONLY.
NOT TO BE RELIED UPON UNLESS CONFIRMED BY SITE INSPECTION AND/OR INVESTIGATION**

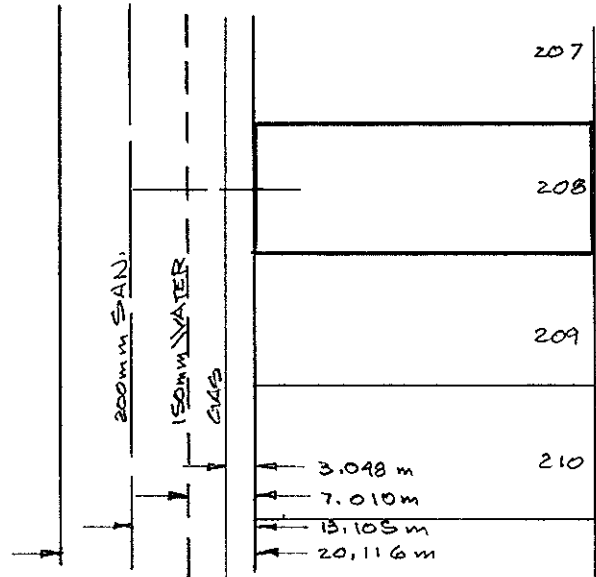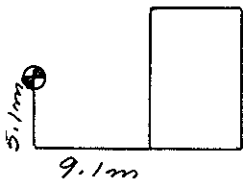

URQUHART
CRES.