



City of Prince George
History Sheet

PID:	008281769
SD/MU:	
WO:	5001554

Civic Address: 2460 Foot St

Legal Description: Lot: 258 District Lot: 21607 Plan: 21607


Service Type	Diameter (mm)	Material	Invert Elev at main (m)	Invert Elev at property line (m)	Invert Elev at service end (m)	Distance into property (m)	Installation Date
Sanitary	100mm	AC	-	-	-	-	December 1973
Water	20mm	Copper	-	-	-	-	December 1973
Storm	N/A	N/A	-	-	-	-	

Service Connection Location				Sanitary (m)	Storm (m)
Distance from downstream San MH	1176	towards upstream San MH	1041	50.15	
Distance from downstream Stm MH	-	towards upstream Stm MH	-		

Power	Size	Communications	Size	Cable	Size	Gas	Size
BC Hydro	-	Telus	-	Shaw	-	FortisBC	-
Underground Service		Underground Service		Underground Service			

Installed by:		Survey Date:	-
Comments:	Maintenance performed on sanitary service on July 2015		

NOT TO SCALE The information contained herein is for internal use only.
Not to be relied on unless confirmed by site inspection and/or investigation.

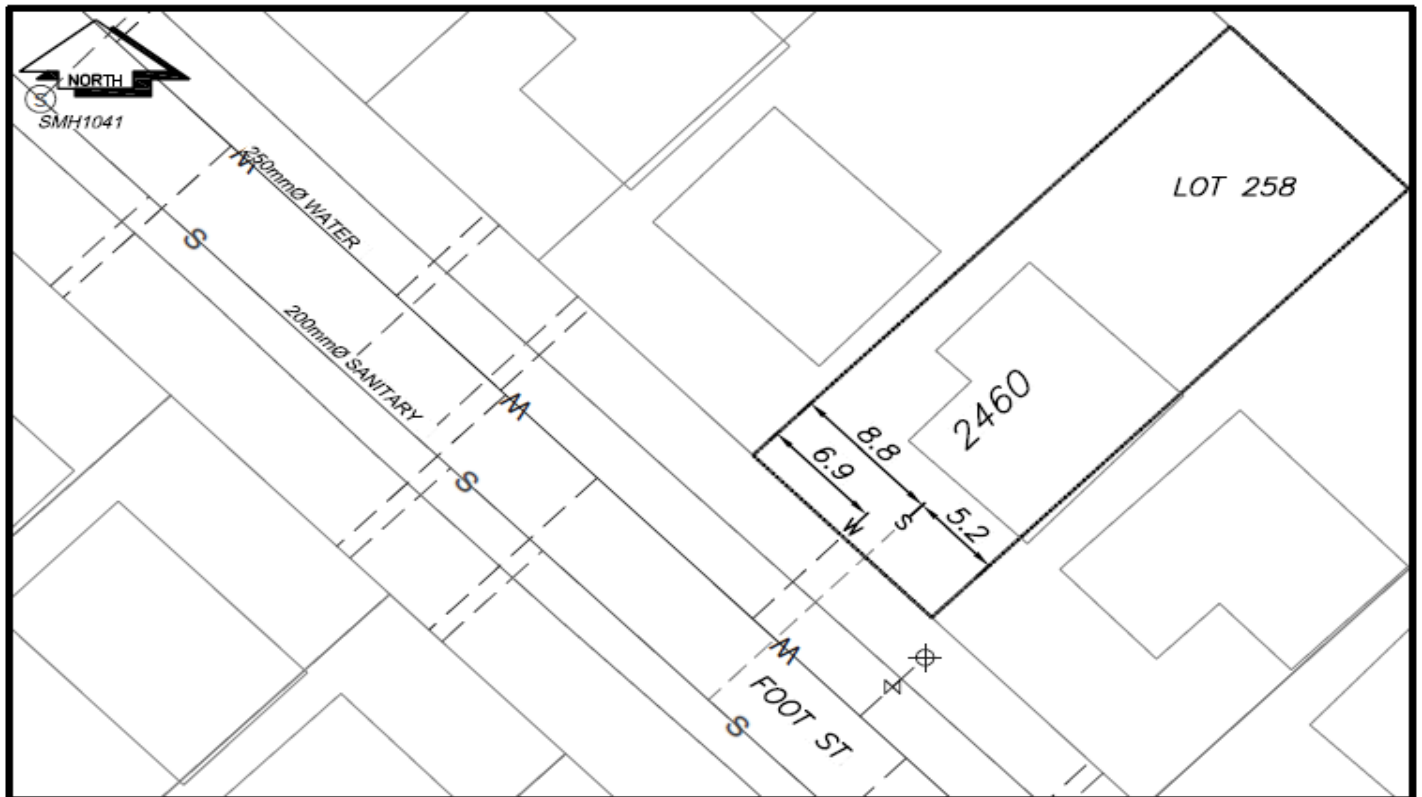

LEGEND:		
CS	CURB STOP	—W— WATER SERVICE
CO	CLEAN OUT	- - - - - SANITARY SERVICE
X	WATER VALVE	—G— GAS
		—M— STORM SERVICE
		- - - - - ENCUMBRANCE
		⊕ FIRE HYDRANT

NOT TO SCALE