

**City of Prince George  
HISTORY SHEET**

008282609

ET NUMBER

Roll Number

Legal: LOT'S 5 BLOCK \_\_\_\_\_ D.L. 4046 PLAN 24336

Address: 2944 Ingala

Sanitary Connection: # \_\_\_\_\_ SIZE 4" MATERIAL P.V.C. INV. 2383.11 CONNECTED

Water Connection # \_\_\_\_\_ SIZE 3/4" MATERIAL Copper METER \_\_\_\_\_ CONNECTED

Storm Connection: # None SIZE \_\_\_\_\_ MATERIAL \_\_\_\_\_ INV. \_\_\_\_\_ CONNECTED

Cash Receipt No's: WATER \_\_\_\_\_ SANITARY \_\_\_\_\_ STORM \_\_\_\_\_

CURB FROM PROPERTY LINE Ditch PAVEMENT WIDTH 28'

B.C. HYDRO OH UNDERGROUND CONNECTION


B.C. TELEPHONE OH UNDERGROUND CONNECTION

INLAND GAS \_\_\_\_\_

Information Sheets: \_\_\_\_\_

Comments: B.M. Hyd. spin. N.W. Cor. Croft & Oakridge 2385.43 City # 1979

SITE PLAN N.T.S.

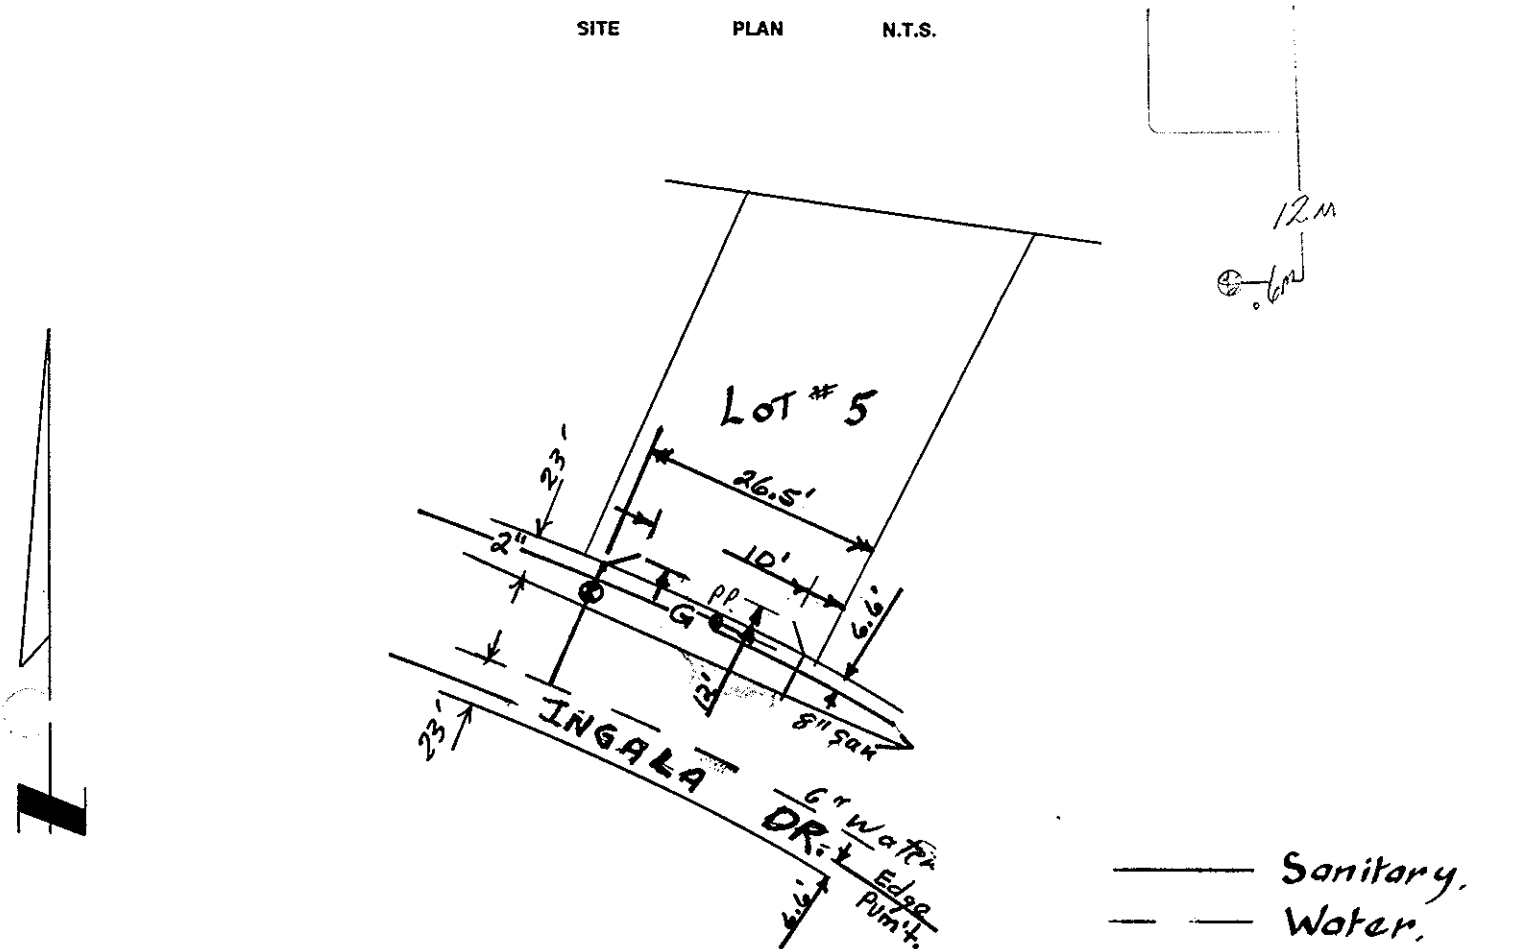

— Sanitary.  
— Water.