



City of Prince George
History Sheet

PID:	008282617
SD/MU:	
WO:	

Civic Address: 2968 Ingala Dr

Legal Description: Lot: 3 District Lot: 4046 Plan: 24336


Service Type	Diameter (mm)	Material	Invert Elev at main (m)	Invert Elev at property line (m)	Invert Elev at service end (m)	Distance into property (m)	Installation Date
Sanitary	100mm	PVC	-	-	-	-	December 1976
Water	20mm	Copper	-	-	-	-	August 2019
Storm	N/A	N/A	-	-	-	-	

Service Connection Location				Sanitary (m)	Storm (m)
Distance from downstream San MH	594	towards upstream San MH	593	54.41	
Distance from downstream Stm MH	-	towards upstream Stm MH	-		

Power	Size	Communications	Size	Cable	Size	Gas	Size
BC Hydro	-	Telus	-	Shaw	-	FortisBC	-
Overhead Service		Overhead Service		Overhead Service			

Installed by:	Water service installed by City of Prince George forces	Survey Date:	-
Comments:			

NOT TO SCALE The information contained herein is for internal use only.
Not to be relied on unless confirmed by site inspection and/or investigation.

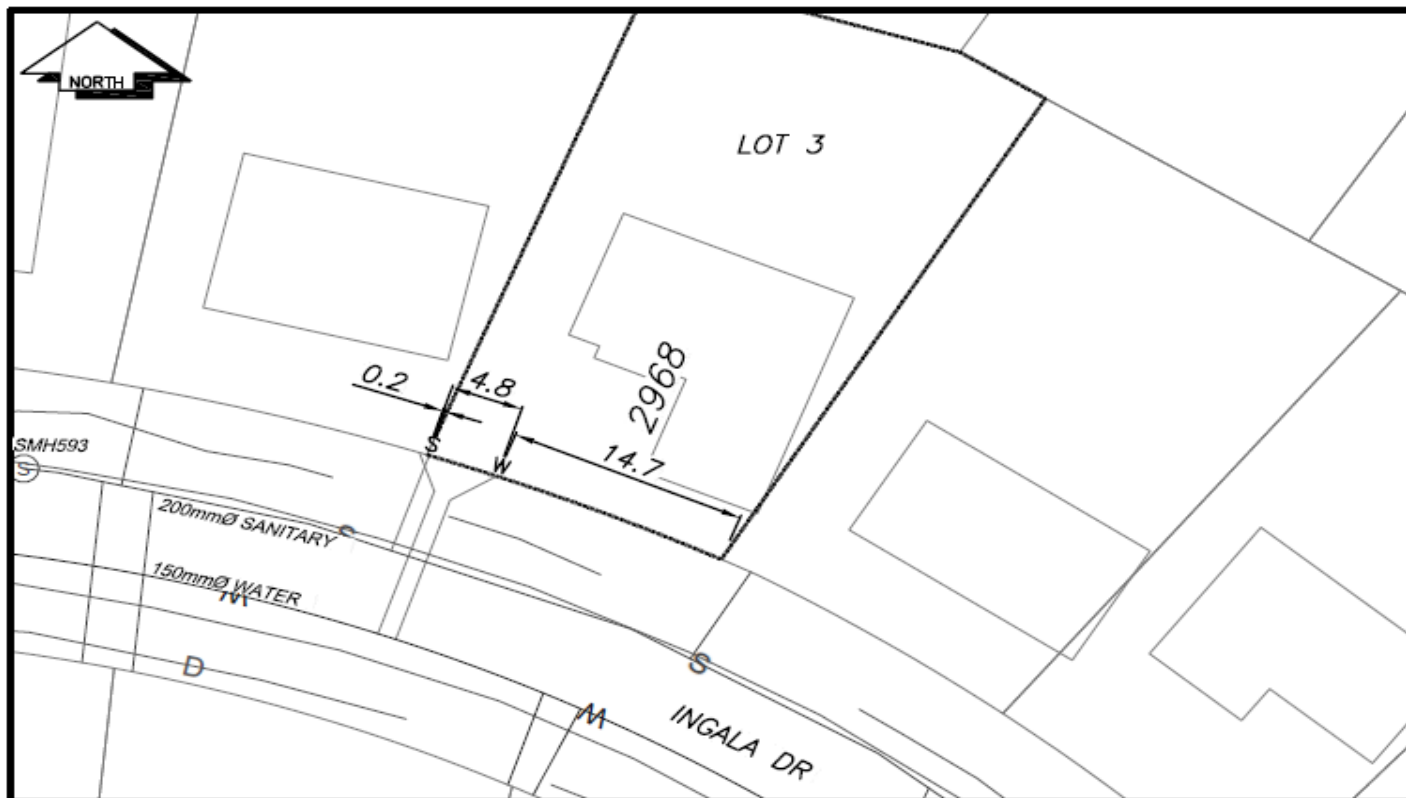

LEGEND:	
CS ^o CURB STOP	—W— WATER SERVICE
CO ^o CLEAN OUT	- - - - - S SANITARY SERVICE
⊗ WATER VALVE	⊗ FIRE HYDRANT
	—G— GAS
	- - - - - ENCUMBERANCE

NOT TO SCALE