

**City of Prince George
HISTORY SHEET**

008282 889

ET NUMBER

Roll Number

Legal: LOT'S 11 BLOCK _____ D.L. 4046 PLAN 24336

Address: 2874. INGALA DR.

Sanitary Connection: # _____ SIZE 4" MATERIAL P.V.C. INV. 2396.05 CONNECTED

Water Connection # _____ SIZE 3/4" MATERIAL COPPER METER _____ CONNECTED

Storm Connection: # None SIZE _____ MATERIAL _____ INV. _____ CONNECTED

Cash Receipt No's: WATER _____ SANITARY _____ STORM _____

CURB FROM PROPERTY LINE Ditch PAVEMENT WIDTH 28'

B.C. HYDRO OH UNDERGROUND CONNECTION

B.C. TELEPHONE OH UNDERGROUND CONNECTION


INLAND GAS _____

Information Sheets:

Comments: B.M. Hyd. spin. N.W. Cor. Croft & Oakridge 2385.43 City #1979

THE INFORMATION CONTAINED HEREIN IS FOR INTERNAL
USE ONLY. NOT TO BE RELIED UPON UNLESS CONFIRMED
BY SITE INSPECTION AND/OR INVESTIGATION.

SITE PLAN N.T.S.

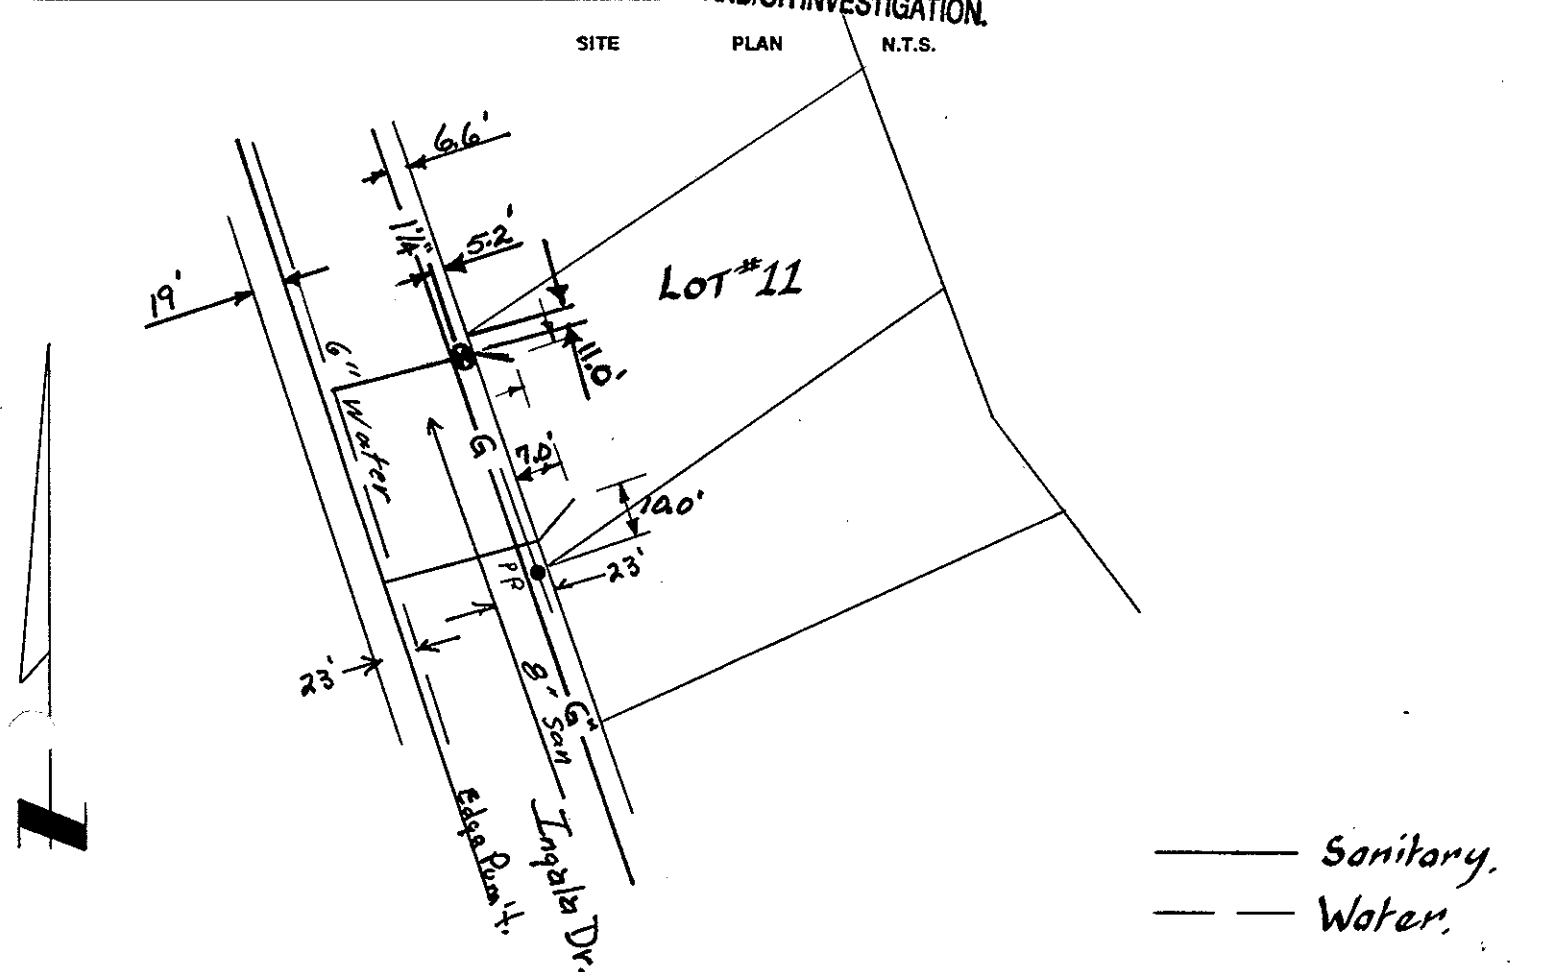

—— Sanitary.
—— Water.