

City of Prince George HISTORY SHEET

SHEET NUMBER

PID # **008 284016**

Legal: LOTS **6** BLOCK D.L. **777** PLAN **17401**

Address: **2699 ABBOTT CRES.**

Sanitary Connection: # **6403** SIZE **100** mm MATERIAL **A.C.** INV. **585.266** CONNECTED

Water Connection: # **6403** SIZE **20** mm MATERIAL **CU.** METER CONNECTED

Storm Connection: # SIZE mm MATERIAL INV. CONNECTED

Cash Receipt No's: WATER SANITARY STORM

CURB FROM PROPERTY LINE **4.877 m** PAVEMENT WIDTH **10.363 m**

B.C. HYDRO **U/G** UNDERGROUND CONNECTION



B.C. TELEPHONE **U/G** UNDERGROUND CONNECTION

INLAND GAS **3.048 m FROM R.**

Information Sheets:

Comments: **WITH THAW WIRE.**

**THE INFORMATION CONTAINED HEREIN IS FOR INTERNAL USE ONLY.
NOT TO BE RELIED UPON UNLESS CONFIRMED BY SITE INSPECTION AND/OR INVESTIGATION**

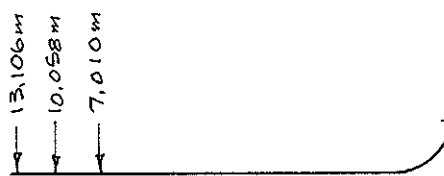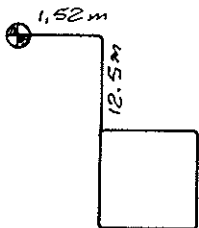

ABBOTT CRES.

