



City of Prince George  
**History Sheet**

PID:	008286655
SD/MU:	
WO:	

Civic Address: 4329 1st Ave  
Legal Description: Lot: 6 District Lot: 2608 Plan: 20043


Service Type	Diameter (mm)	Material	Invert Elev at main (m)	Invert Elev at property line (m)	Invert Elev at service end (m)	Distance into property (m)	Installation Date
Sanitary	100mm	AC	-	-	-	-	January 1971
Water	20mm	Copper	-	-	-	-	January 1971
Storm	N/A	N/A	-	-	-	-	

Service Connection Location				Sanitary (m)	Storm (m)
Distance from downstream San MH	2343	towards upstream San MH	2331	1.50	
Distance from downstream Stm MH	-	towards upstream Stm MH	-		

Power	Size	Communications	Size	Cable	Size	Gas	Size
BC Hydro	-	Telus	-	Shaw	-	FortisBC	-
Underground Service		Underground Service		Underground Service			

Installed by:	Survey Date:	-
Comments:		

**NOT TO SCALE** The information contained herein is for internal use only.  
Not to be relied on unless confirmed by site inspection and/or investigation.

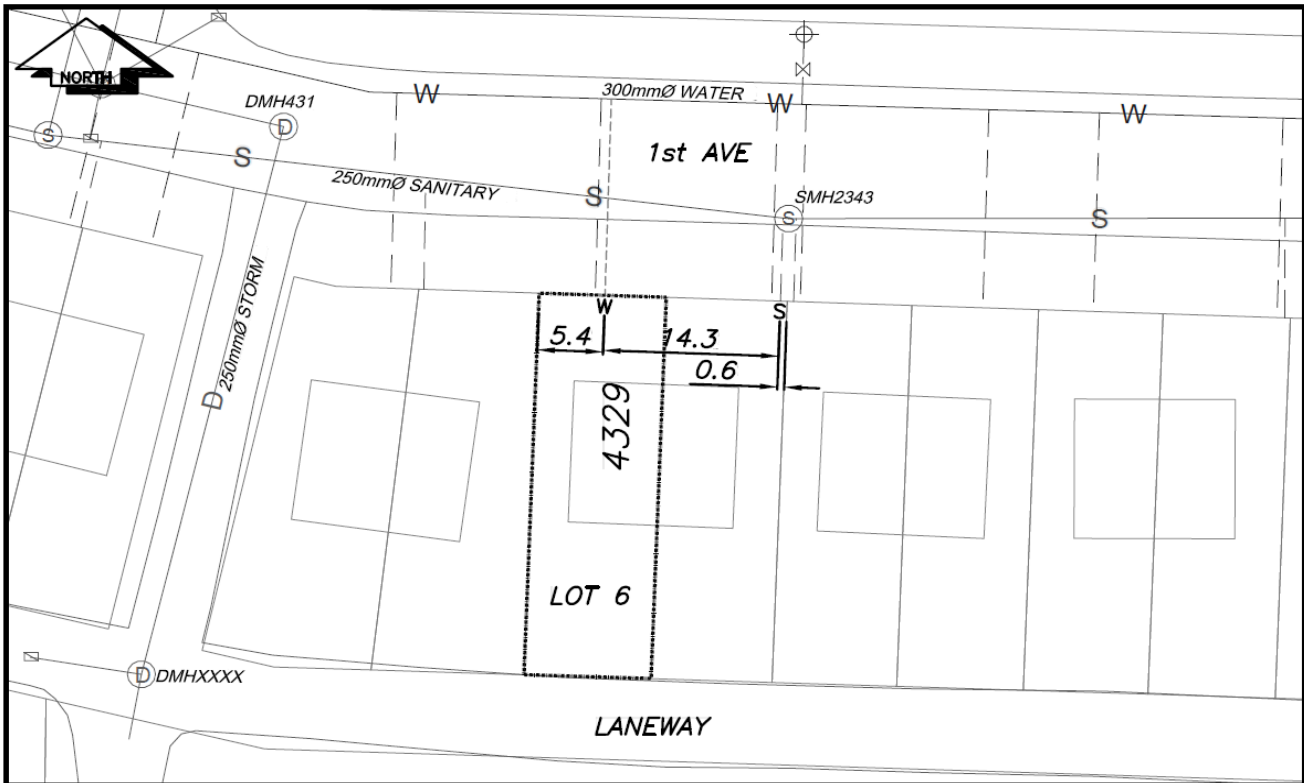

LEGEND:	
CS <sup>o</sup>	CURB STOP
CO <sup>o</sup>	CLEAN OUT
⊗	WATER VALVE
— — —	WATER SERVICE
- - - - -	SANITARY SERVICE
⊕	FIRE HYDRANT
—o—	STORM SERVICE
—G—	GAS
- - - - -	ENCUMBRANCE

**NOT TO SCALE**