



City of Prince George
History Sheet

| | |
|--------|-----------|
| PID: | 008290121 |
| SD/MU: | |
| WO: | |

Civic Address: 2390 Wiggins Pl

Legal Description: Lot: 22 District Lot: 931 Plan: 24282


| Service Type | Diameter (mm) | Material | Invert Elev at main (m) | Invert Elev at property line (m) | Invert Elev at service end (m) | Distance into property (m) | Installation Date |
|--------------|---------------|----------|-------------------------|----------------------------------|--------------------------------|----------------------------|-------------------|
| Sanitary | 100mm | AC | - | - | - | - | December 1977 |
| Water | 20mm | Copper | 582.84 | - | - | - | August 2019 |
| Storm | 100mm | AC | - | - | - | - | December 1977 |

| Service Connection Location | | | | Sanitary (m) | Storm (m) |
|---------------------------------|------|-------------------------|------|--------------|-----------|
| Distance from downstream San MH | 1089 | towards upstream San MH | 1094 | 30.23 | |
| Distance from downstream Stm MH | - | towards upstream Stm MH | - | | |

| Power | Size | Communications | Size | Cable | Size | Gas | Size |
|------------------|------|------------------|------|------------------|------|----------|------|
| BC Hydro | - | Telus | - | Shaw | - | FortisBC | - |
| Overhead Service | | Overhead Service | | Overhead Service | | | |

| | | | |
|---------------|---|--------------|---|
| Installed by: | Water service installed by City of Prince George forces | Survey Date: | - |
| Comments: | | | |
| | | | |

NOT TO SCALE The information contained herein is for internal use only.
Not to be relied on unless confirmed by site inspection and/or investigation.

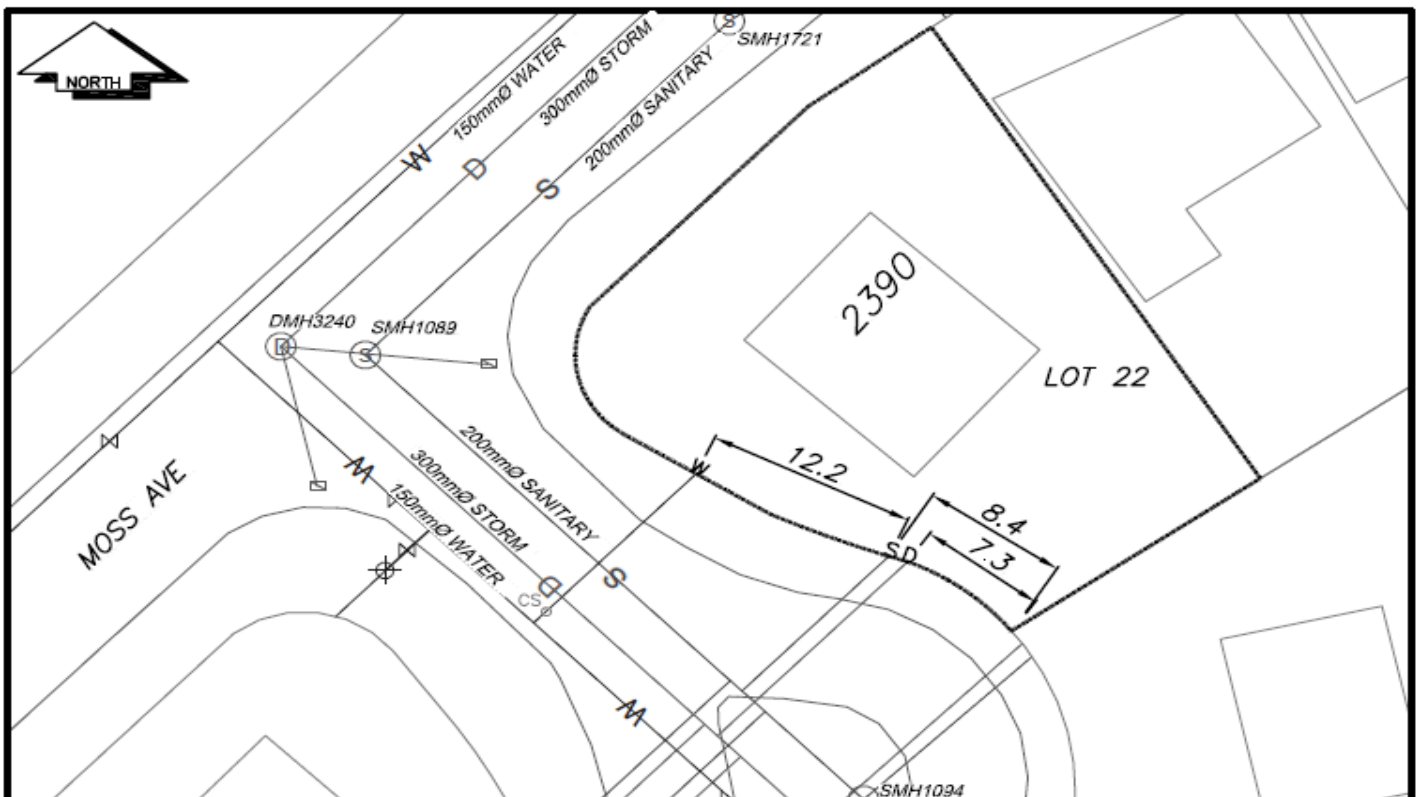

| LEGEND: | | | | | |
|---------|-------------|-----------|------------------|-----------|---------------|
| CS | CURB STOP | W | WATER SERVICE | ○ | STORM SERVICE |
| CO | CLEAN OUT | - - - - - | SANITARY SERVICE | - G - | GAS |
| ⊗ | WATER VALVE | ⊗ | FIRE HYDRANT | - - - - - | ENCUMBERANCE |

NOT TO SCALE