

City of Prince George  
HISTORY SHEET

608317691

SHEET NUMBER

3656

Roll Number

Legal: LOT'S 20 BLOCK D.L. 4040 PLAN 24178

Address: 3977 BRETTWOOD COURT

Sanitary Connection: # SIZE 4" MATERIAL P.V.C. INV. 2183.50 CONNECTED

Water Connection # SIZE 3/4" MATERIAL CO. METER CONNECTED

Storm Connection: # SIZE MATERIAL INV. CONNECTED

Cash Receipt No's: WATER SANITARY STORM

CURB FROM PROPERTY LINE PAVEMENT WIDTH 28'

B.C. HYDRO UNDERGROUND CONNECTION ✓


B.C. TELEPHONE UNDERGROUND CONNECTION ✓

INLAND GAS

Information Sheets:

Comments:

SITE PLAN N.T.S.

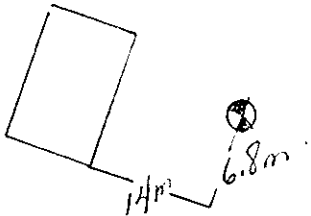

LOT 20

