



City of Prince George
History Sheet

PID:	008317852
SD/MU:	
WO:	

Civic Address: 3819 Brentwood Pl

Legal Description: Lot: 13 District Lot: 4040 Plan: 24178


Service Type	Diameter (mm)	Material	Invert Elev at main (m)	Invert Elev at property line (m)	Invert Elev at service end (m)	Distance into property (m)	Installation Date
Sanitary	100mm	PVC	-	668.09	668.98	0.30	December 1977
Water	20mm	Copper	-	668.27	668.25	1.20	December 1977
Storm	N/A	N/A	-	-	-	-	

Service Connection Location				Sanitary (m)	Storm (m)
Distance from downstream San MH	1402	towards upstream San MH	1400	32.35	
Distance from downstream Stm MH	-	towards upstream Stm MH	-		

Power	Size	Communications	Size	Cable	Size	Gas	Size
BC Hydro	-	Telus	-	Shaw	-	FortisBC	-
Overhead Service		Overhead Service		Overhead Service			

Installed by:		Survey Date:	-
Comments:	Repairs completed on water and sanitary on April 2015		

NOT TO SCALE The information contained herein is for internal use only.
Not to be relied on unless confirmed by site inspection and/or investigation.

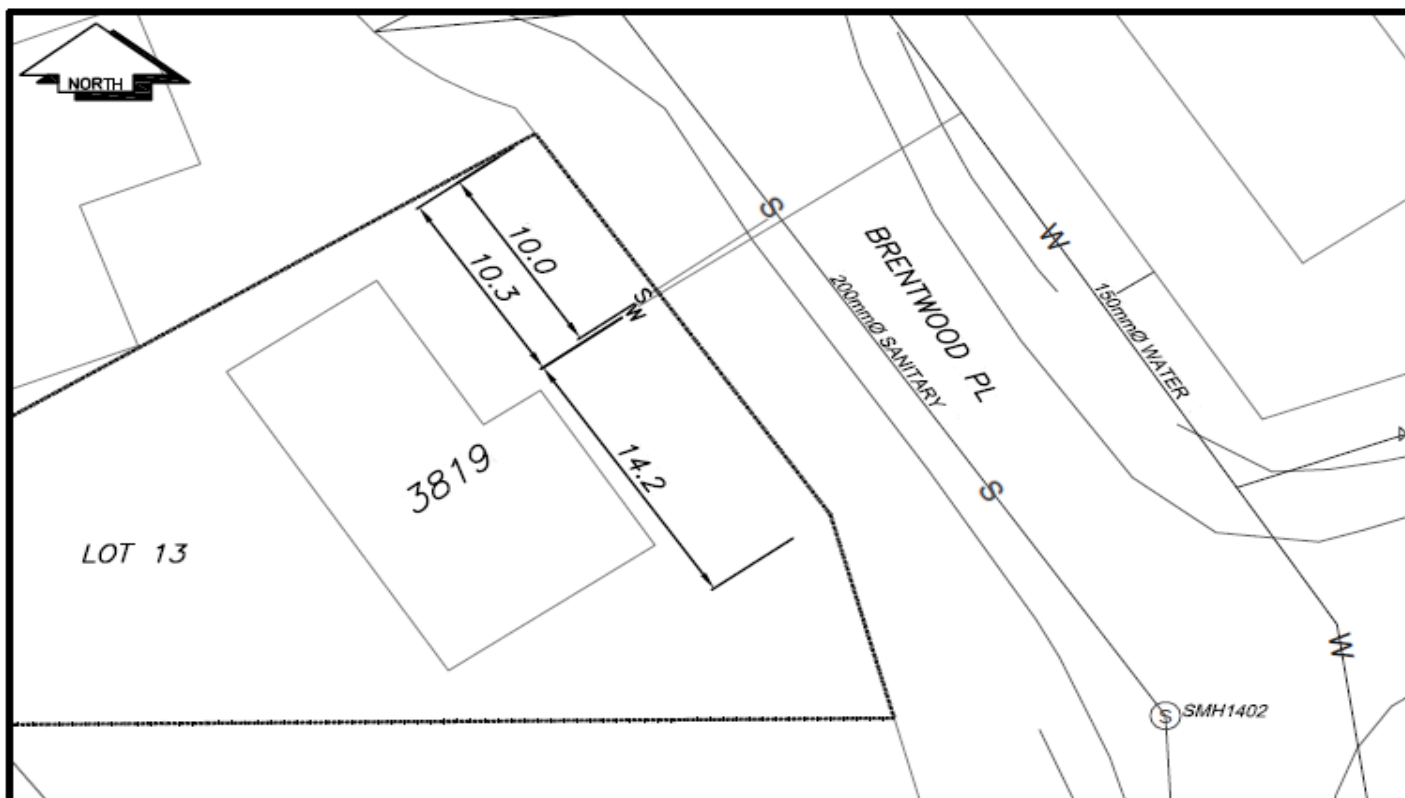

LEGEND:	CURB STOP	WATER SERVICE	STORM SERVICE
	CLEAN OUT	SANITARY SERVICE	GAS
	WATER VALVE	FIRE HYDRANT	ENCUMBRANCE

NOT TO SCALE