

**City of Prince George
HISTORY SHEET**

08325278

SHEET NUMBER

Roll Number

286

Legal: LOT'S 1-2 BLOCK 103 D.L. 937 PLAN 752

Address: 187 N. NICHOLSON

Sanitary Connection: # 3309 SIZE 100mm MATERIAL A.C. INV. 601.768 CONNECTED

Water Connection # 3326 SIZE 20mm MATERIAL C.U. METER CONNECTED

Storm Connection: # SIZE MATERIAL INV. CONNECTED

Cash Receipt No's: WATER SANITARY STORM

CURB FROM PROPERTY LINE 4.877 m PAVEMENT WIDTH 10.363


B.C. HYDRO O/H UNDERGROUND CONNECTION

B.C. TELEPHONE O/H UNDERGROUND CONNECTION


INLAND GAS 1.524 m FROM WEST SIDE OF LANE.

Information Sheets:

Comments: WITH THAW WIRE.

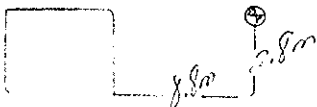

SITE PLAN N.T.S.

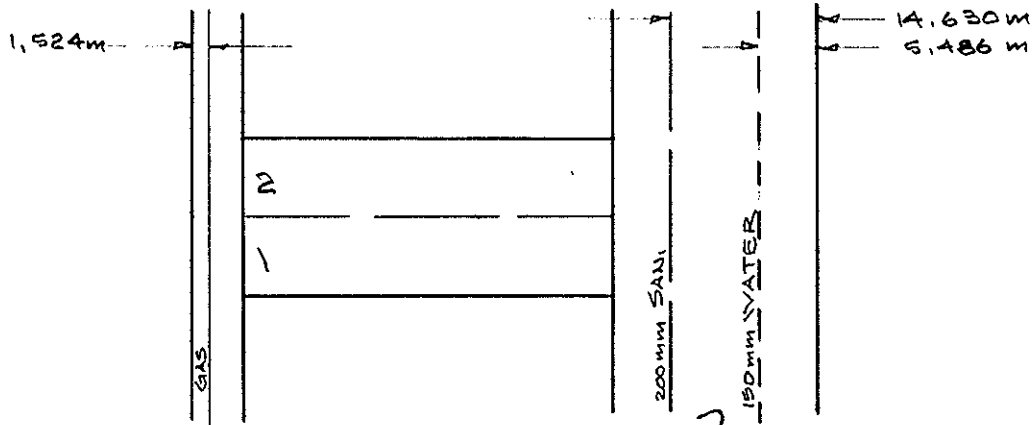

NICHOLSON ST.

