

**City of Prince George
HISTORY SHEET**

308325294

308

SHEET NUMBER

Roll Number

Legal: LOT'S 21-22 BLOCK 102 D.L. 937 PLAN 752

Address: 172 N. NICHOLSON ST.

Sanitary Connection: # 3287 SIZE 100mm MATERIAL A.C. INV. 602.835 CONNECTED

Water Connection # 3321 SIZE 20mm MATERIAL CU. METER CONNECTED

Storm Connection: # SIZE MATERIAL INV. CONNECTED

Cash Receipt No's: WATER SANITARY STORM

CURB FROM PROPERTY LINE 4.877m PAVEMENT WIDTH 10.363m

B.C. HYDRO 9/4 UNDERGROUND CONNECTION

B.C. TELEPHONE 9/4 UNDERGROUND CONNECTION


INLAND GAS 1.524m FROM R IN LANE.

Information Sheets:

Comments: WITH THAW WIRE.



SITE PLAN N.T.S.

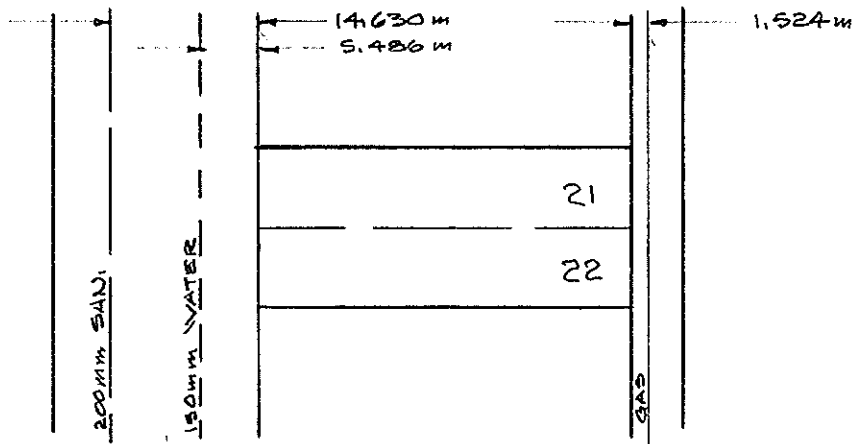

N. NICHOLSON ST.

