

**City of Prince George
HISTORY SHEET**

J0832554
529

SHEET NUMBER _____ Roll Number _____

Legal: LOT'S 13-A BLOCK 102 D.L. 937 PLAN 752

Address: 108 N. NICHOLSON ST.

Sanitary Connection: # 3291 SIZE 100MM MATERIAL A.C. INV. 602.820 CONNECTED

Water Connection # 3325 SIZE 20MM MATERIAL C.U. METER CONNECTED

Storm Connection: # _____ SIZE _____ MATERIAL _____ INV. _____ CONNECTED

Cash Receipt No's: WATER _____ SANITARY _____ STORM _____

CURB FROM PROPERTY LINE 4.877m PAVEMENT WIDTH 10.363m


B.C. HYDRO O/H UNDERGROUND CONNECTION

B.C. TELEPHONE O/H UNDERGROUND CONNECTION


INLAND GAS 1.524m FROM R IN LANE.

Information Sheets: _____

Comments: WITH THAW WIRE.

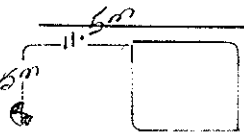

SITE PLAN N.T.S.

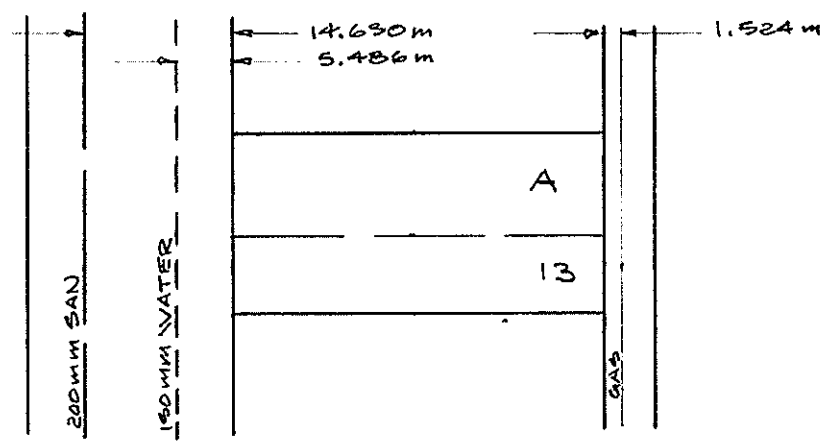

N. NICHOLSON ST.