



City of Prince George
History Sheet

PID:	008362700
SD/MU:	
WO:	

Civic Address: 505, 277 Becott Pl

Legal Description: Lot: 1 District Lot: 343 Plan: 32450 & DL 417 except Plan PGP46330


Service Type	Diameter (mm)	Material	Invert Elev at main (m)	Invert Elev at property line (m)	Invert Elev at service end (m)	Distance into property (m)	Installation Date
Sanitary	150mm	AC	-	-	-	-	December 1969
Water	150mm	PVC	-	-	-	-	June 2000
Storm	N/A	N/A	-	-	-	-	

Service Connection Location				Sanitary (m)	Storm (m)
Distance from downstream San MH	3409	towards upstream San MH	3317	106.45	
Distance from downstream Stm MH	-	towards upstream Stm MH	-		

Power	Size	Communications	Size	Cable	Size	Gas	Size
BC Hydro	-	Telus	-	Shaw	-	FortisBC	-
Overhead Service		Overhead Service		Overhead Service			

Installed by:	Survey Date:	-
Comments:		

NOT TO SCALE The information contained herein is for internal use only.
Not to be relied on unless confirmed by site inspection and/or investigation.

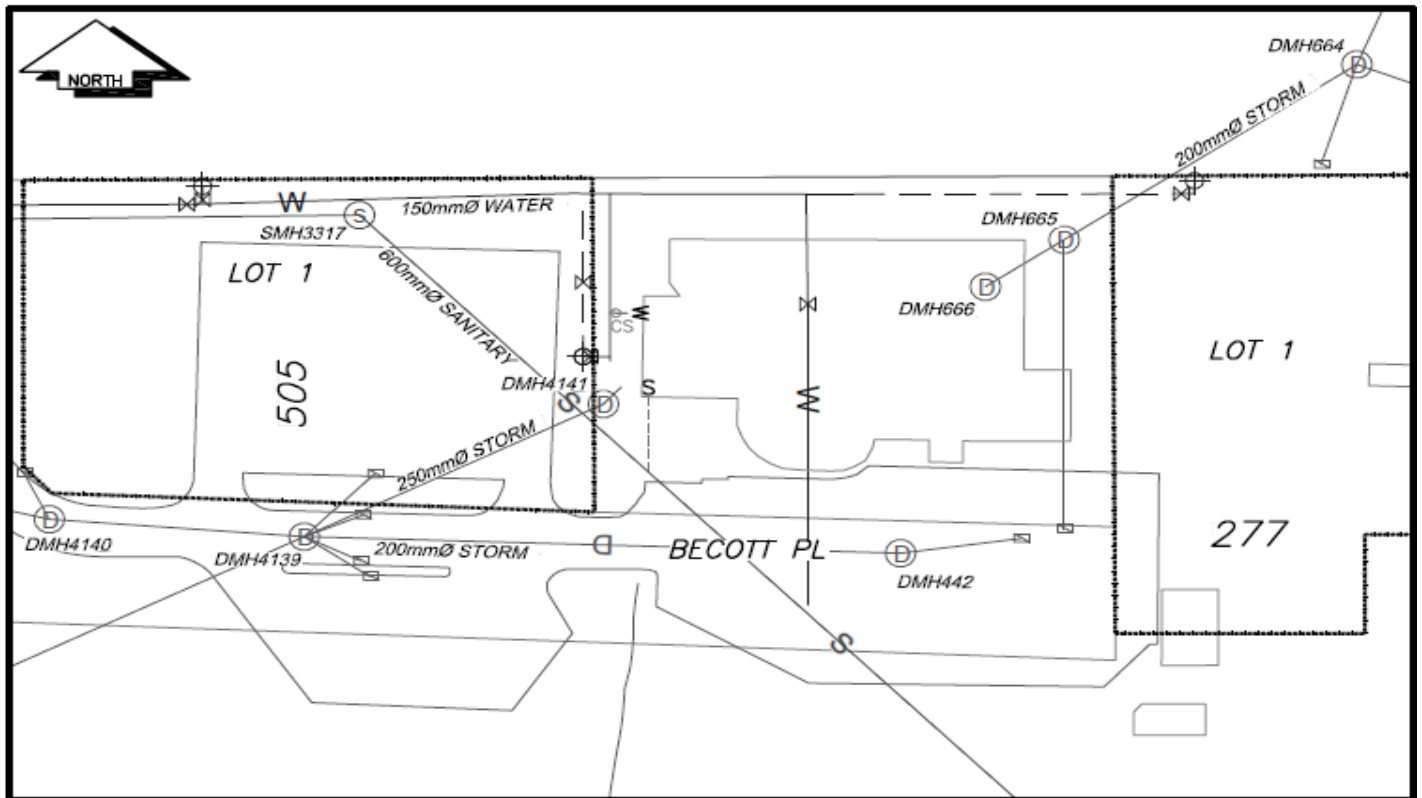

LEGEND:					
CS	CURB STOP	—W—	WATER SERVICE	—D—	STORM SERVICE
CO	CLEAN OUT	- - - - -S	SANITARY SERVICE	—G—	GAS
X	WATER VALVE	—X—	FIRE HYDRANT	- - - - -	ENCUMBRANCE

NOT TO SCALE