



City of Prince George
History Sheet

PID:	008404623
MU:	100309
WO:	18837-18840

Civic Address: 5911 O'Grady Rd
Legal Description: Lot: A District Lot: 753 Plan: 30915


Service Type	Diameter (mm)	Material	Invert Elev at main (m)	Invert Elev at property line (m)	Invert Elev at service end (m)	Distance into property (m)	Installation Date
Sanitary	150mm	PVC	647.15	647.45	-	-	October 2004
Water	150mm	PVC	647.70	-	-	-	October 2004
Storm	250mm	PVC	-	647.70	-	-	October 2004

Service Connection Location	Sanitary (m)	Storm (m)
150mm Sanitary service connected to San MH4852	-	
250mm Storm connected to Stm MH1383		

Power	Size	Communications	Size	Cable	Size	Gas	Size
BC Hydro	-	Telus	-	Shaw	-	FortisBC	-
Underground Service		Underground Service		Underground Service			

Installed by:	Survey Date:	-
Comments:		

NOT TO SCALE The information contained herein is for internal use only.
Not to be relied on unless confirmed by site inspection and/or investigation.

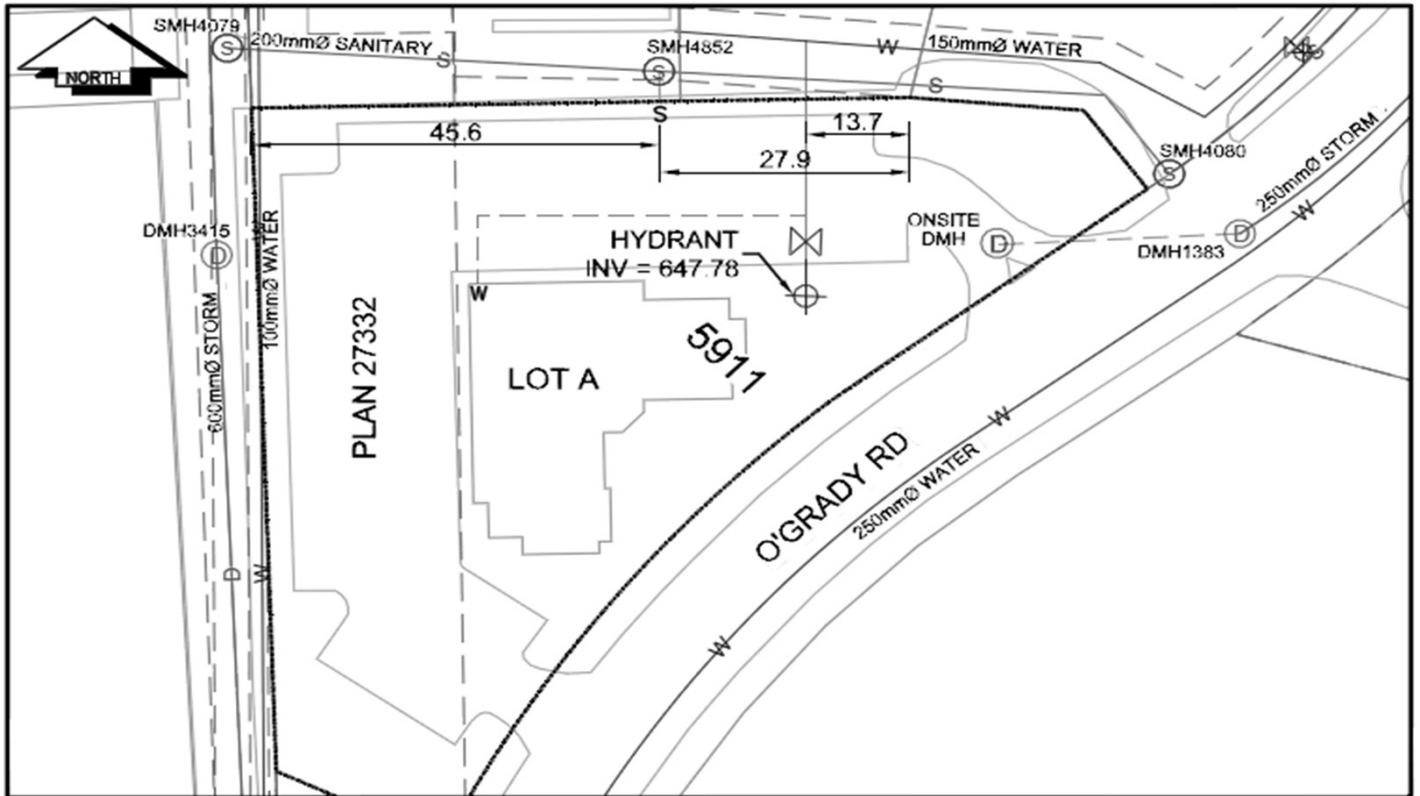

NOT TO SCALE