

**City of Prince George
HISTORY SHEET**

000755480
434

SHEET NUMBER

Roll Number

Legal: LOT'S 4-5 BLOCK 109 D.L. 938 PLAN 132.

Address: 129 Moffat

Sanitary Connection: # 1374 SIZE _____ MATERIAL _____ INV. _____ CONNECTED _____

Water Connection # 4117 SIZE 20mm MATERIAL Cu METER _____ CONNECTED _____

Storm Connection: # _____ SIZE _____ MATERIAL _____ INV. _____ CONNECTED _____

Cash Receipt No's: WATER _____ SANITARY _____ STORM _____

CURB FROM PROPERTY LINE 4.2m PAVEMENT WIDTH 10.4m


B.C. HYDRO _____ UNDERGROUND CONNECTION _____

B.C. TELEPHONE _____ UNDERGROUND CONNECTION _____

INLAND GAS _____

Information Sheets: _____

Comments: _____

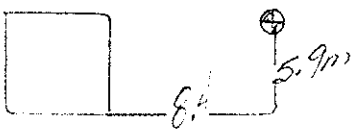

SITE PLAN N.T.S.

