

**City of Prince George
HISTORY SHEET**

008434115
174

SHEET NUMBER _____ Roll Number _____

Legal: LOT'S 24-A BLOCK 109 D.L. 937 PLAN 752

Address: 116 N. NICHOLSON ST.

Sanitary Connection: # 3292 SIZE 100 mm MATERIAL A.C INV. 602.469 CONNECTED

Water Connection # 3343 SIZE 20 mm MATERIAL CU. METER CONNECTED

Storm Connection: # _____ SIZE _____ MATERIAL _____ INV. _____ CONNECTED

Cash Receipt No's: WATER _____ SANITARY _____ STORM _____

CURB FROM PROPERTY LINE 4.877 m PAVEMENT WIDTH 10.363 m


B.C. HYDRO 0/H UNDERGROUND CONNECTION

B.C. TELEPHONE 0/H UNDERGROUND CONNECTION


INLAND GAS 1.524 m FROM R IN LANE.

Information Sheets: _____

Comments: WITH THAW WIRE.

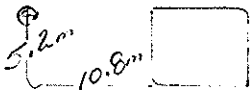

SITE PLAN N.T.S.

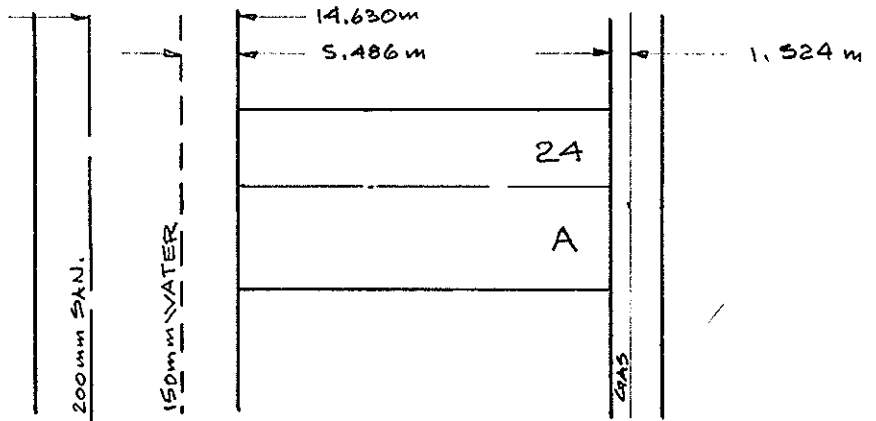

N. NICHOLSON ST.

