

City of Prince George
HISTORY SHEET

008434803

SHEET NUMBER

Roll Number

824

Legal: LOT'S 1-B BLOCK 109 D.L. 957 PLAN 752

Address: 109 MORRIS

Sanitary Connection: # SIZE MATERIAL INV. CONNECTED

Water Connection # SIZE 10mm MATERIAL Cu METER CONNECTED

Storm Connection: # SIZE MATERIAL INV. CONNECTED

Cash Receipt No's: WATER SANITARY STORM

CURB FROM PROPERTY LINE PAVEMENT WIDTH


B.C. HYDRO UNDERGROUND CONNECTION

B.C. TELEPHONE UNDERGROUND CONNECTION

INLAND GAS

Information Sheets:

Comments:

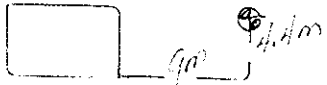

SITE PLAN N.T.S.

