

City of Prince George HISTORY SHEET

SHEET NUMBER

Roll Number

Legal: LOT'S 11-8 BLOCK 108 D.L. 937 PLAN 11-8

Address: 161 Nicholson St

Sanitary Connection: # 3300 SIZE _____ MATERIAL _____ INV. _____ CONNECTED _____

Water Connection # 3335 SIZE 20mm MATERIAL Cu METER _____ CONNECTED _____

Storm Connection: # _____ SIZE _____ MATERIAL _____ INV. _____ CONNECTED _____

Cash Receipt No's: WATER _____ SANITARY 1199 STORM _____

CURB FROM PROPERTY LINE 4.8m PAVEMENT WIDTH 10.9m


B.C. HYDRO _____ UNDERGROUND CONNECTION _____

B.C. TELEPHONE _____ UNDERGROUND CONNECTION _____

INLAND GAS _____

Information Sheets:

Comments:

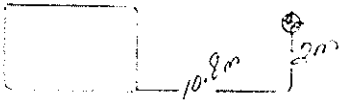

SITE PLAN N.T.S.

