

City of Prince George
HISTORY SHEET

SHEET NUMBER

Roll Number 008443734

Legal: LOT'S 81 BLOCK D.L. 754 PLAN 23862

Address: 7635 ST. MARK CRESCENT

Sanitary Connection: # SIZE 4" MATERIAL P.V.C. INV. CONNECTED

Water Connection # SIZE 3/4" MATERIAL COPPER METER CONNECTED

Storm Connection: # SIZE 4" MATERIAL PVC INV. CONNECTED

Cash Receipt No's: WATER SANITARY STORM

CURB FROM PROPERTY LINE 16 PAVEMENT WIDTH 34

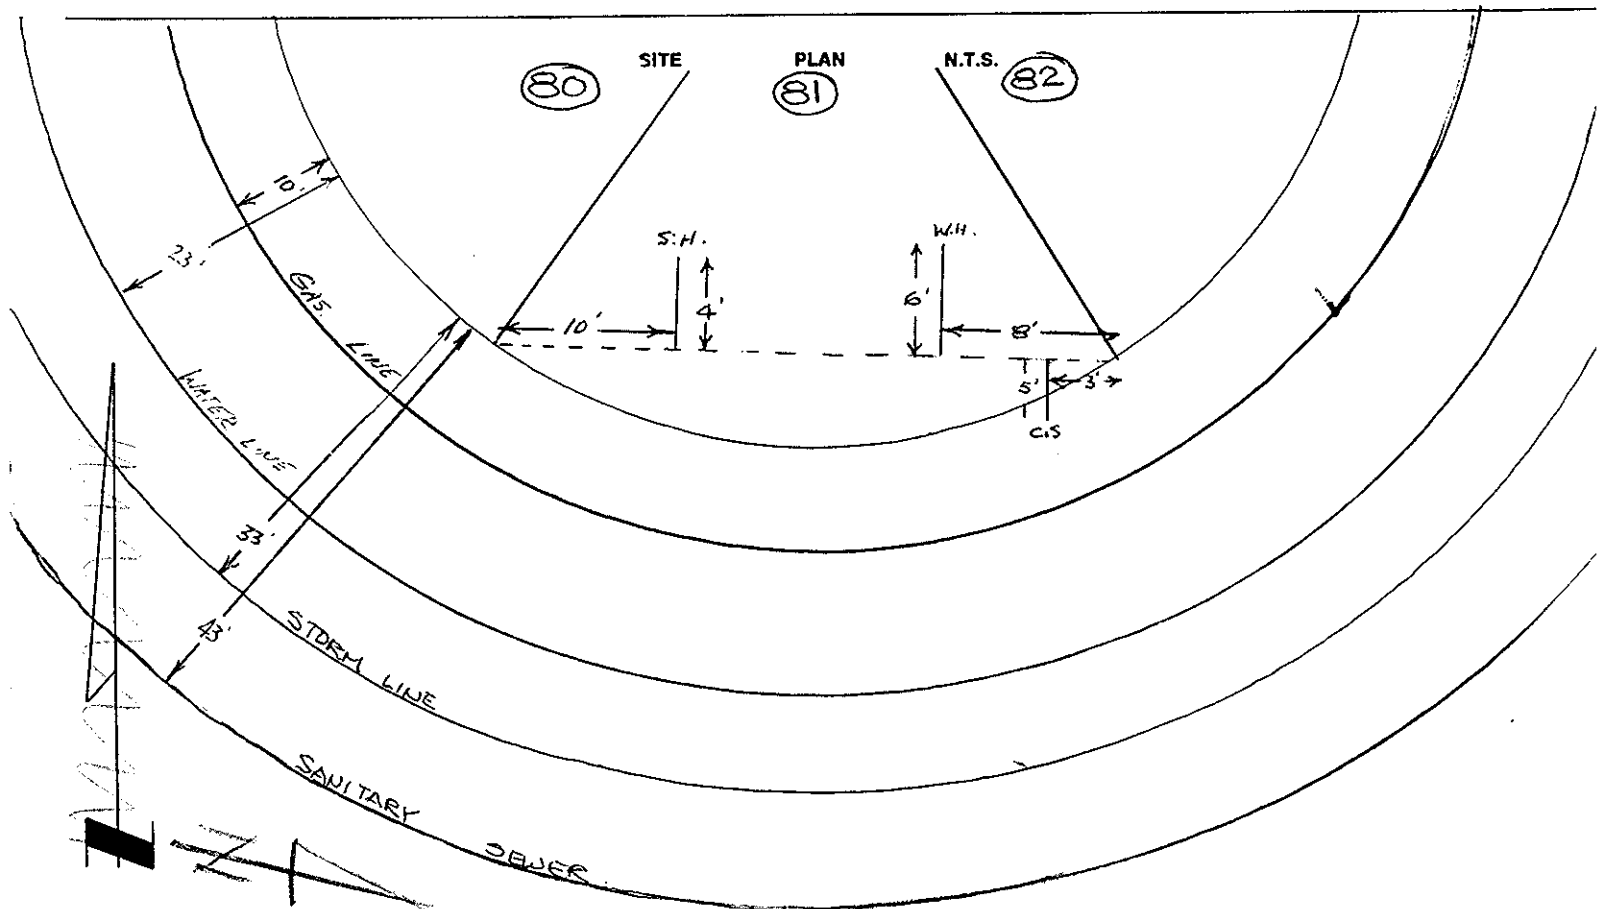
B.C. HYDRO 3 UNDERGROUND CONNECTION ✓

B.C. TELEPHONE 3 UNDERGROUND CONNECTION ✓

INLAND GAS 10'

Information Sheets:

Comments: 66' R/W THE INFORMATION CONTAINED HEREIN IS FOR INTERNAL
USE ONLY. NOT TO BE RELIED UPON UNLESS CONFIRMED
BY SITE INSPECTION AND/OR INVESTIGATION.



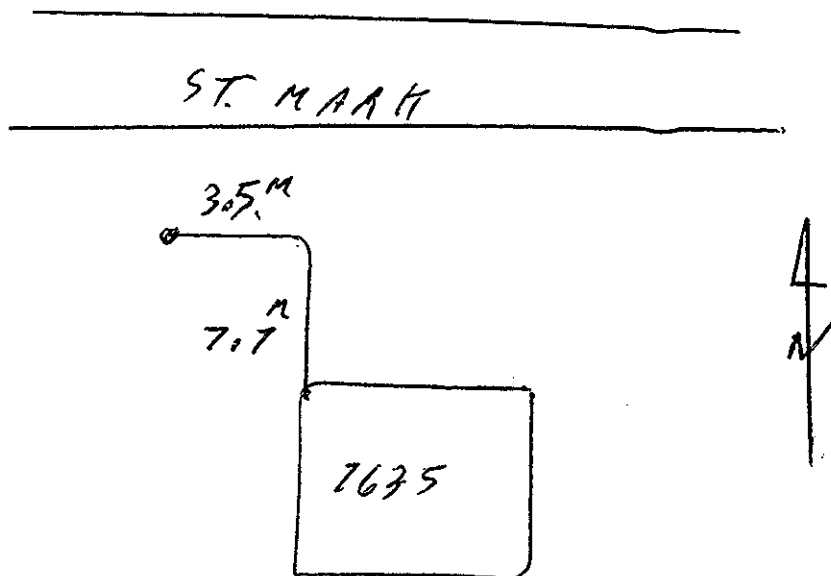
008443734

REPORT TO RECORDS

WATER SERVICE INFORMATION

Lot No. 81 Block 754 D.L. _____Address 7635 ST. MARKSize of Connection ☐ 1/2" ☒ 3/4" ☐ Other _____Type of Connection ☐ Copper ☐ IronThaw Wire ☐ Yes ☐ No

LOCATION SKETCH

Field Location By Alexis La Cruz Date MARCH 20/96

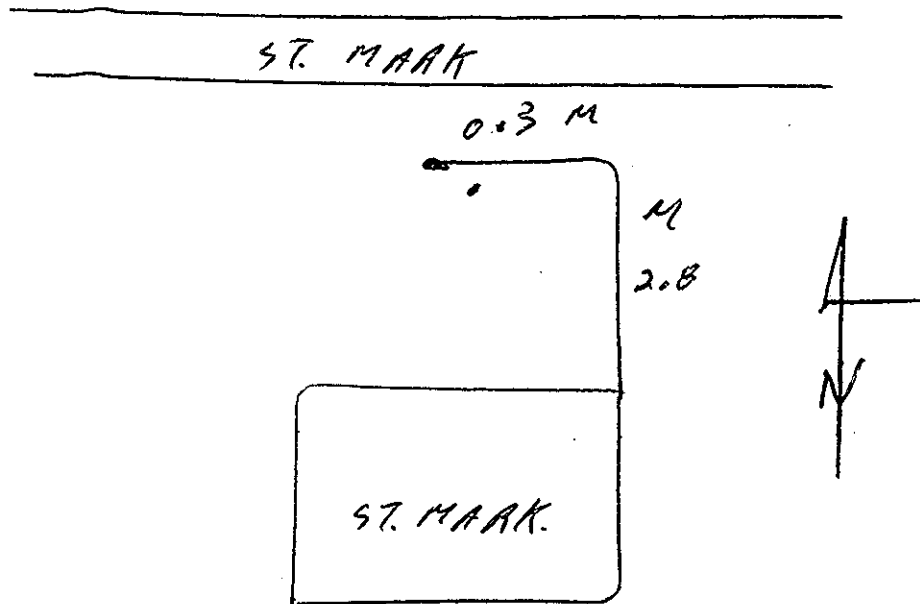
Checked by: _____

REPORT TO RECORDS

SEWER SERVICE INFORMATION

Lot No. 81 Block 754 D.L. _____Address 7635 ST. MARK.Size of Connection ☒ 100mm ☐ 150mm ☐ 200mm ☐ Other _____Type of Connection ☐ Transite ☒ PVC ☐ Other _____Type of Cap ☐ Transite ☒ Cast Iron

LOCATION SKETCH

Field Location By A. Davis, Jr. - CWT Date MARCH 20/96.

Checked by Foreman - Sewer Division _____