

**City of Prince George
HISTORY SHEET**

211
008446245
261

SHEET NUMBER

Roll Number

Legal: LOT'S 5-6-7 BLOCK 103 D.L. 937 PLAN 752

Address: 155 N. NICHOLSON ST.

Sanitary Connection: # 3307 SIZE 100 mm MATERIAL A.C. INV. 601,768 CONNECTED

Water Connection # 3328 SIZE 20 mm MATERIAL C.U. METER CONNECTED

Storm Connection: # SIZE MATERIAL INV. CONNECTED

Cash Receipt No's: WATER SANITARY STORM

CURB FROM PROPERTY LINE 4,877 m PAVEMENT WIDTH 10,363 m


B.C. HYDRO O/H UNDERGROUND CONNECTION

B.C. TELEPHONE O/H UNDERGROUND CONNECTION


INLAND GAS 1,524 m FROM WEST SIDE OF LANE,

Information Sheets:

Comments: WITH THAW WIRE.

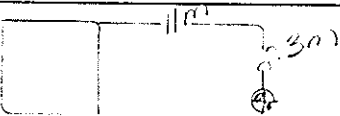

SITE PLAN N.T.S.

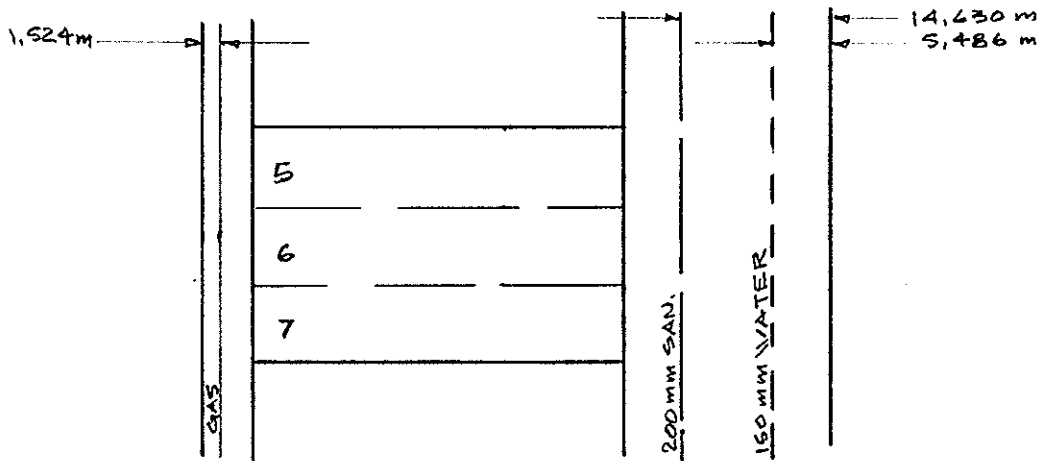

N NICHOLSON ST.