

**City of Prince George
HISTORY SHEET**

009447011

9

SHEET NUMBER **N^o 1871** Roll Number

Legal: LOT'S **5,6** BLOCK **317** D.L. **343** PLAN **1268**

Address: **1845 REDWOOD ST.**

Sanitary Connection: # **4970** SIZE **4"** MATERIAL **A.C.S.** INV. **CONNECTED**

Water Connection # **4273** SIZE **3/4"** MATERIAL **COPPER** METER **CONNECTED**

Storm Connection: # SIZE MATERIAL INV. **CONNECTED**

Cash Receipt No's: WATER SANITARY STORM

CURB FROM PROPERTY LINE PAVEMENT WIDTH

B.C. HYDRO UNDERGROUND CONNECTION



B.C. TELEPHONE UNDERGROUND CONNECTION

INLAND GAS

Information Sheets:

Comments:

SITE PLAN N.T.S.

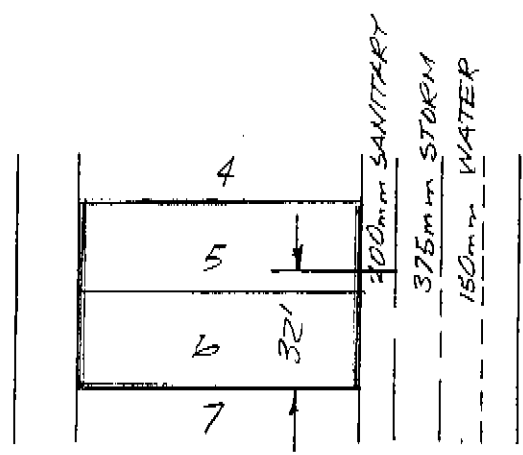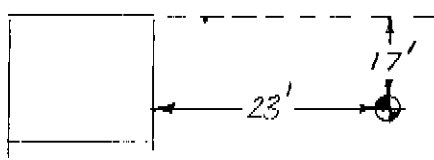

REDWOOD