



City of Prince George
History Sheet

PID:	008457077
	008457115
	008457123
	008457131
	008457158
SD/MU:	
WO:	

Civic Address: 307 Lyon St

Legal Description: Lot: 1 - 5 Block: 133 District Lot: 938 Plan: 752


Service Type	Diameter (mm)	Material	Invert Elev at main (m)	Invert Elev at property line (m)	Invert Elev at service end (m)	Distance into property (m)	Installation Date
Sanitary	100mm	AC	-	-	-	-	December 1961
Water	20mm	Copper	-	-	-	-	December 1961
Storm	N/A	N/A	-	-	-	-	

Service Connection Location				Sanitary (m)	Storm (m)
Distance from downstream San MH	2413	towards upstream San MH	2414	30.73	
Distance from downstream Stm MH	-	towards upstream Stm MH	-		

Power	Size	Communications	Size	Cable	Size	Gas	Size
BC Hydro	-	Telus	-	Shaw	-	FortisBC	-
Overhead Service		Overhead Service		Overhead Service			

Installed by:		Survey Date:	-
Comments:	Water service located on April 30, 2019		

NOT TO SCALE The information contained herein is for internal use only.
Not to be relied on unless confirmed by site inspection and/or investigation.

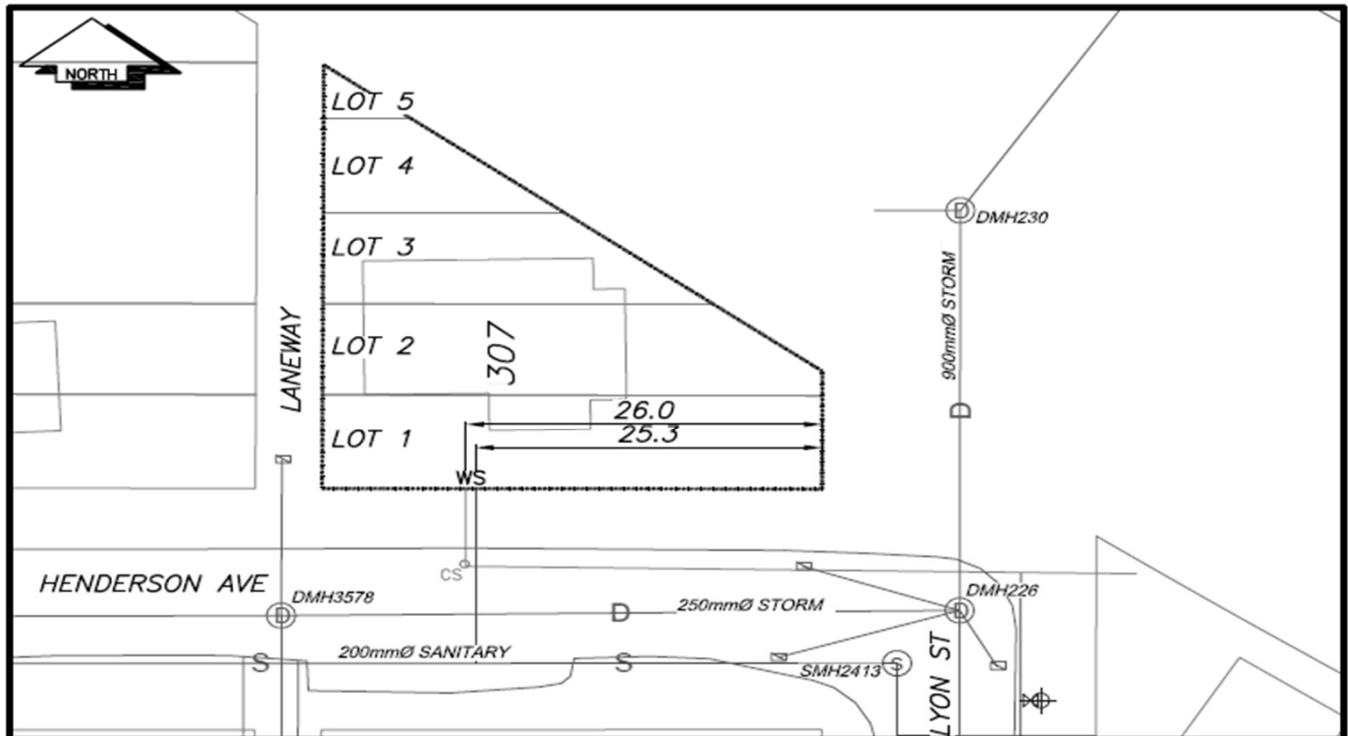

CS ^o	CURB STOP	— W	WATER SERVICE	— S	STORM SERVICE
CO ^o	CLEAN OUT	- - - S	SANITARY SERVICE	— G	GAS
⊗	WATER VALVE	— F	FIRE HYDRANT	- - -	ENCUMBRANCE

NOT TO SCALE