

**City of Prince George  
HISTORY SHEET**

SHEET NUMBER **4720** Roll Number **008458065**

Legal: LOT'S **33** BLOCK D.L. **8174** PLAN **23799**

Address: **3672 GOULD CRES.**

Sanitary Connection: # SIZE **4"** MATERIAL **A.C.** INV. **53.18** CONNECTED

Water Connection # SIZE **3/4"** MATERIAL **CU.** METER CONNECTED

Storm Connection: # SIZE MATERIAL INV. CONNECTED

Cash Receipt No's: WATER SANITARY STORM

CURB FROM PROPERTY LINE **16'** (ROLL CURB) PAVEMENT WIDTH **34'**

B.C. HYDRO UNDERGROUND CONNECTION


B.C. TELEPHONE UNDERGROUND CONNECTION

INLAND GAS

Information Sheets:

Comments: **BENCH MARK** **ELEV. 1955.25**  
**S.W. COR. OSPIKA & GOULD** **S.LEG.**  
**LEV. BK.# 333**

SITE PLAN N.T.S.

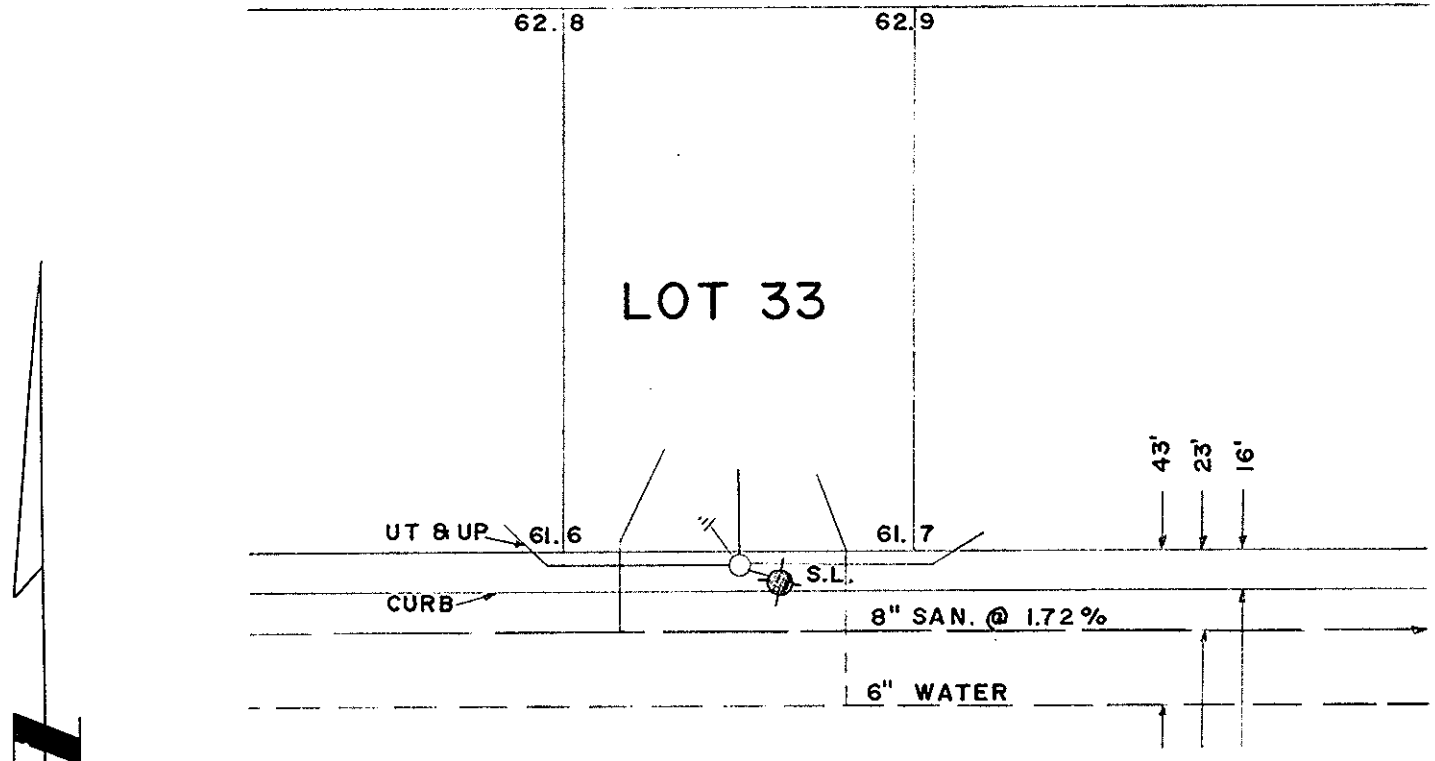

**GOULD CRES.**