



City of Prince George  
**History Sheet**

PID:	008462704
SD/MU:	
WO:	

Civic Address: 393 Burden St

Legal Description: Lot: B District Lot: 343 Plan: 23724


Service Type	Diameter (mm)	Material	Invert Elev at main (m)	Invert Elev at property line (m)	Invert Depth at service end (m)	Distance into property (m)	Installation Date
Sanitary	100mm	Vit	-	587.75	1.93	-	December 1957
Water	20mm	Copper	-	-	-	-	December 1957
Storm	N/A	N/A	-	-	-	-	

Service Connection Location				Sanitary (m)	Storm (m)
Distance from downstream San MH	1650	towards upstream San MH	1647	29.43	
Distance from downstream Stm MH	-	towards upstream Stm MH	-		

Power	Size	Communications	Size	Cable	Size	Gas	Size
BC Hydro	-	Telus	-	Shaw	-	FortisBC	-
Overhead Service		Overhead Service		Overhead Service			

Installed by:		Survey Date:	-
Comments:	Water service location confirmed on May 15, 2019		

**NOT TO SCALE** The information contained herein is for internal use only.  
Not to be relied on unless confirmed by site inspection and/or investigation.

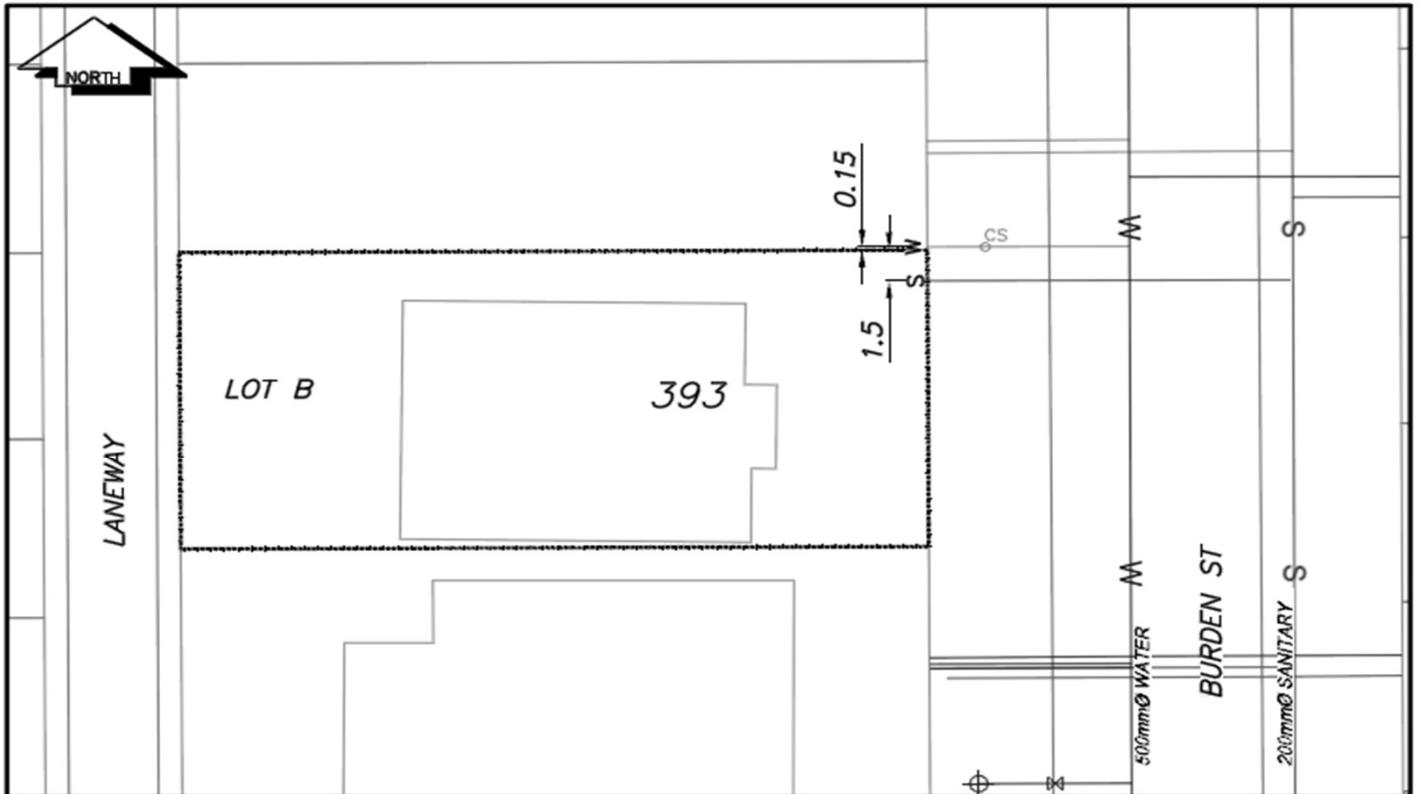

LEGEND:			
CS	CURB STOP	M	WATER SERVICE
CO	CLEAN OUT	S	SANITARY SERVICE
⊗	WATER VALVE	⊕	FIRE HYDRANT
		G	GAS
		- - - -	ENCUMBRANCE

**NOT TO SCALE**