

**City of Prince George
HISTORY SHEET**

SHEET NUMBER **4686** Roll Number **008463883**

Legal: LOT'S **2** BLOCK D.L. **8174** PLAN **22799**

Address: **3610 GOULD CRES.**

Sanitary Connection: # SIZE **4"** MATERIAL **A.C.** INV. **45.37** CONNECTED

Water Connection # SIZE **3/4"** MATERIAL **C.U.** METER CONNECTED

Storm Connection: # SIZE MATERIAL INV. CONNECTED

Cash Receipt No's: WATER SANITARY STORM

CURB FROM PROPERTY LINE **16'** (ROLL CURB) PAVEMENT WIDTH **34'**

B.C. HYDRO UNDERGROUND CONNECTION

B.C. TELEPHONE UNDERGROUND CONNECTION

INLAND GAS


Information Sheets:

Comments: **BENCH MARK** ELEV. **1955.25**

S.W. COR. OSPIKA & GOULD CRES. **S. LEG**

LEV. BK. # **333**

SITE PLAN N.T.S.

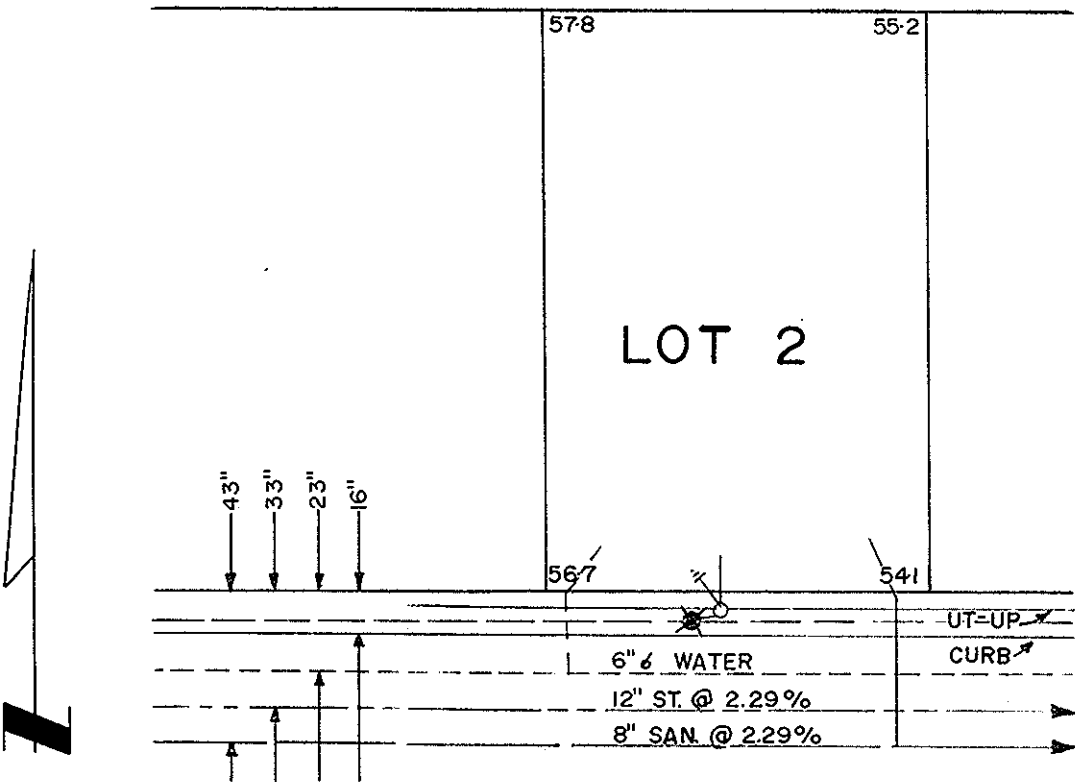

GOULD CRES.