



City of Prince George
History Sheet

PID:	008469679
MU:	101378
WO:	72281

Civic Address: 3902 Kenworth Rd

Legal Description: Lot: A District Lot: 4040 Plan: 23658


Service Type	Diameter (mm)	Material	Invert Elev at main (m)	Invert Elev at property line (m)	Invert Elev at service end (m)	Distance into property (m)	Installation Date
Sanitary	100mm	PVC	-	-	-	-	July 2003
Sanitary	150mm	PVC	-	-	-	-	June 2013
Water	25mm	Copper	-	-	-	-	January 1977
Water	50mm	Copper	-	-	-	-	July 2003
Storm	N/A	N/A	-	-	-	-	-

Service Connection Location				Sanitary (m)	Storm (m)
Distance from downstream San MH	1394	towards upstream San MH	1392	70.20	
Distance from downstream Stm MH	-	towards upstream Stm MH	-		

Power	Size	Communications	Size	Cable	Size	Gas	Size
BC Hydro	-	Telus	-	Shaw	-	FortisBC	-
Overhead Service		Overhead Service		Overhead Service			

Installed by:	City of Prince George forces	Survey Date:	-
Comments:			

NOT TO SCALE The information contained herein is for internal use only.
Not to be relied on unless confirmed by site inspection and/or investigation.

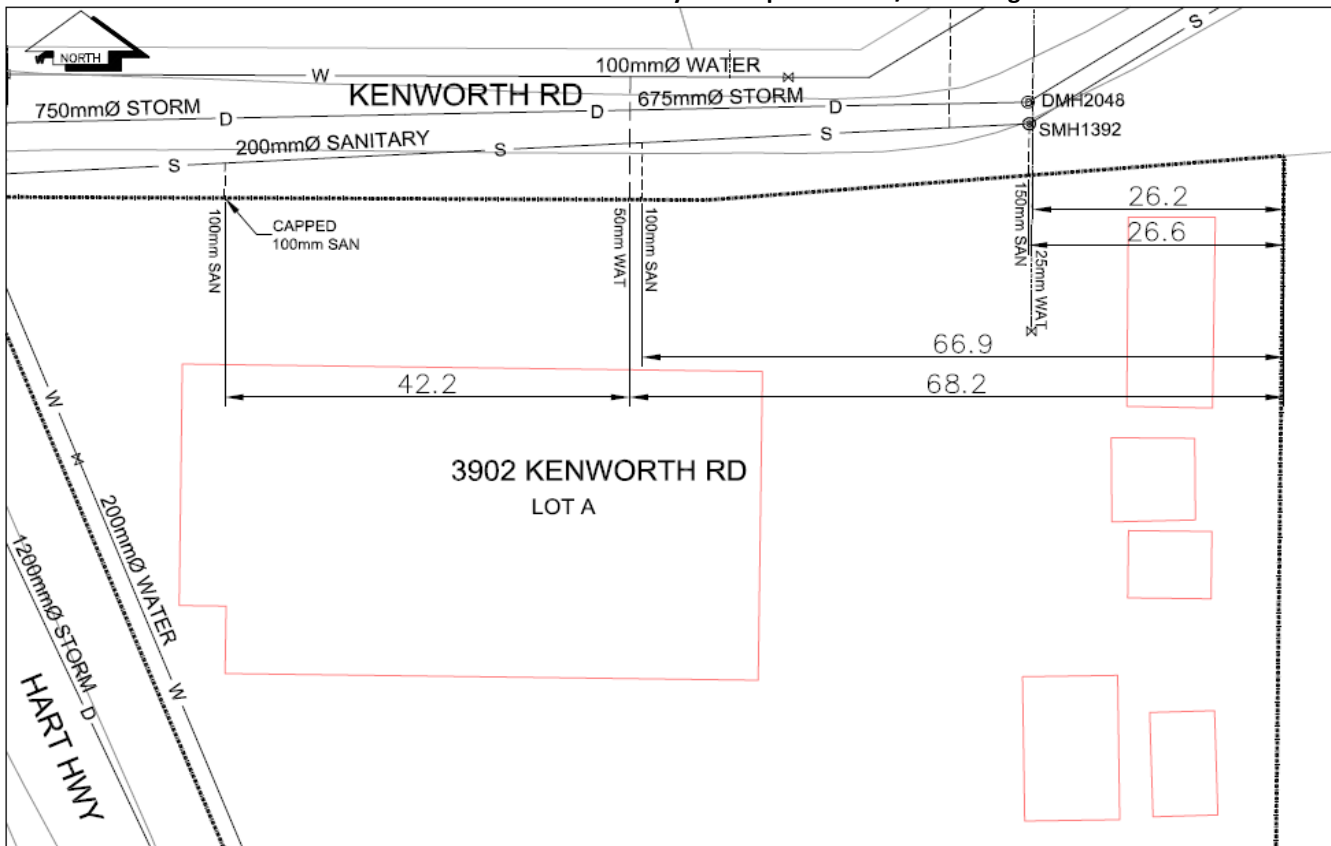

LEGEND:

CS	CURB STOP	---	W	WATER SERVICE	---	D	STORM SERVICE
CO	CLEAN OUT	---	S	SANITARY SERVICE	X		WATER VALVE

NOT TO SCALE