

City of Prince George HISTORY SHEET

008484601

SHEET NUMBER **No 3782** Roll Number

Legal: LOT'S 19, 20 & N 321 BLOCK 123 D.L. 938 PLAN 152

Address: 274 NORTH LYON STREET

Sanitary Connection: # 3317 SIZE _____ MATERIAL _____ INV. _____ CONNECTED _____

Water Connection # 3305 SIZE 3/4" MATERIAL COPPER METER _____ CONNECTED _____

Storm Connection: # _____ SIZE _____ MATERIAL _____ INV. _____ CONNECTED _____

Cash Receipt No's: WATER _____ SANITARY _____ STORM _____

CURB FROM PROPERTY LINE _____ PAVEMENT WIDTH _____

B.C. HYDRO _____ UNDERGROUND CONNECTION _____


B.C. TELEPHONE _____ UNDERGROUND CONNECTION _____

INLAND GAS _____

Information Sheets: _____

Comments: _____

SITE PLAN N.T.S.

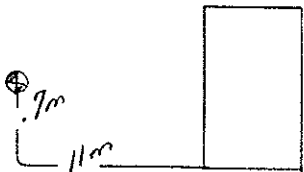

NORTH LYON ST.

