



City of Prince George  
**History Sheet**

PID:	008508101
SD/MU:	
WO:	

Civic Address: 640 Summit St

Legal Description: Lot: 12 District Lot: 2610 Plan: 16227


Service Type	Diameter (mm)	Material	Invert Elev at main (m)	Invert Elev at property line (m)	Invert Depth at service end (m)	Distance into property (m)	Installation Date
Sanitary	100mm	AC	-	601.22	2.37	-	January 1966
Water	20mm	Copper	-	-	-	-	January 1966
Storm	N/A	N/A	-	-	-	-	

Service Connection Location	Sanitary (m)	Storm (m)
100mm Sanitary service connected to San MH2630	-	
Distance from downstream Stm MH - towards upstream Stm MH -		

Power	Size	Communications	Size	Cable	Size	Gas	Size
BC Hydro	-	Telus	-	Shaw	-	FortisBC	-
Underground Service		Underground Service		Underground Service			

Installed by:	Survey Date:	-
Comments: Water service as per May 16. 2017 locate.		

**NOT TO SCALE** The information contained herein is for internal use only.  
Not to be relied on unless confirmed by site inspection and/or investigation.

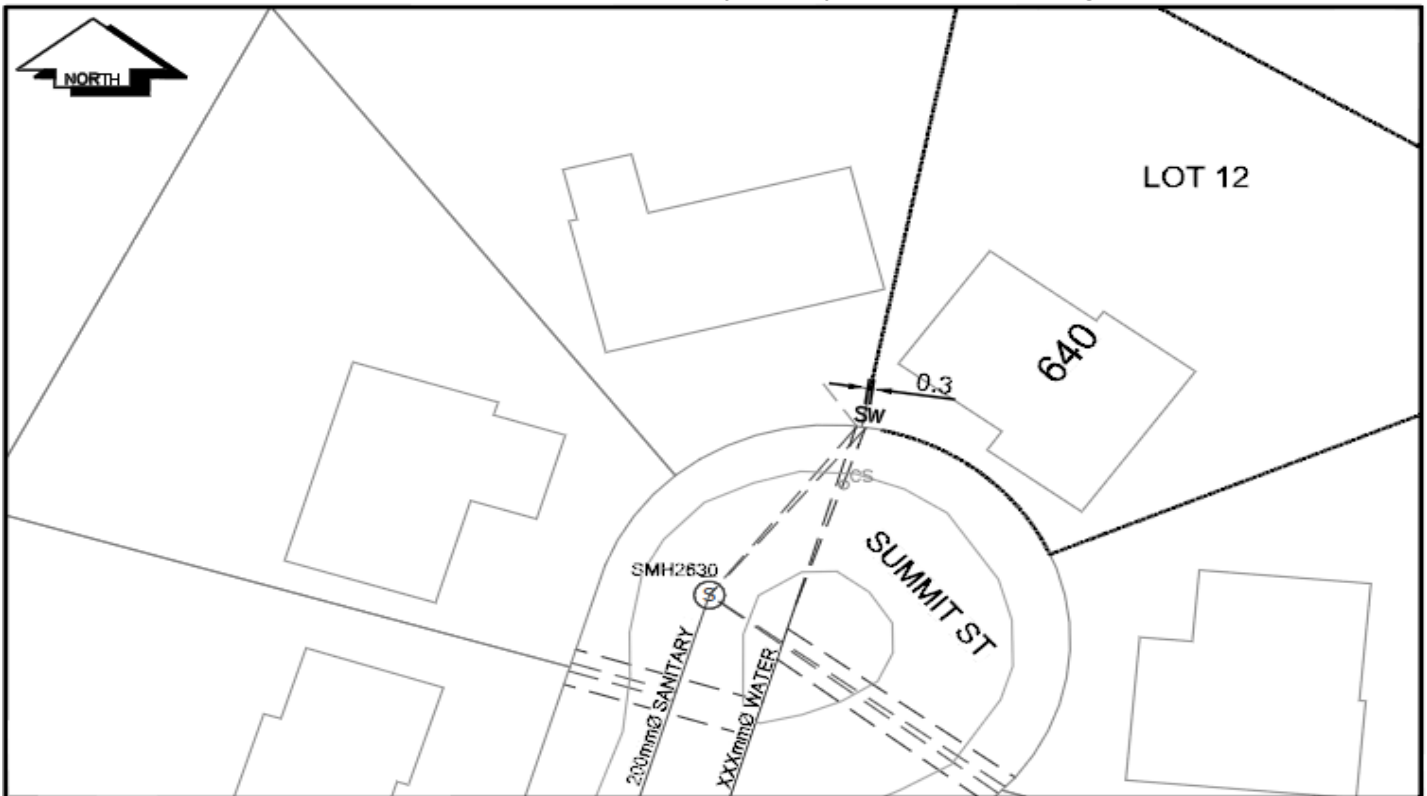

LEGEND:		
CS	CURB STOP	--- W WATER SERVICE
CO	CLEAN OUT	--- S SANITARY SERVICE
⊗	WATER VALVE	--- G GAS
		--- S STORM SERVICE
		--- F FIRE HYDRANT
		--- E ENCUMBRANCE

**NOT TO SCALE**