



City of Prince George
History Sheet

PID:	008512132
SD/MU:	
WO:	

Civic Address: 3808 Forest Pl

Legal Description: Lot: 23 District Lot: 2611 Plan: 23475


Service Type	Diameter (mm)	Material	Invert Elev at main (m)	Invert Elev at property line (m)	Invert Elev at service end (m)	Distance into property (m)	Installation Date
Sanitary	100mm	AC	-	-	-	-	December 1975
Water	20mm	Copper	-	-	-	-	December 1975
Storm	N/A	N/A	-	-	-	-	

Service Connection Location				Sanitary (m)	Storm (m)
Distance from downstream San MH	3040	towards upstream San MH	3039	77.30	
Distance from downstream Stm MH	-	towards upstream Stm MH	-		

Power	Size	Communications	Size	Cable	Size	Gas	Size
BC Hydro	-	Telus	-	Shaw	-	FortisBC	-
Overhead Service		Overhead Service		Overhead Service			

Installed by:		Survey Date:	-
Comments:	Water service location confirmed April 2019		

NOT TO SCALE The information contained herein is for internal use only.
Not to be relied on unless confirmed by site inspection and/or investigation.

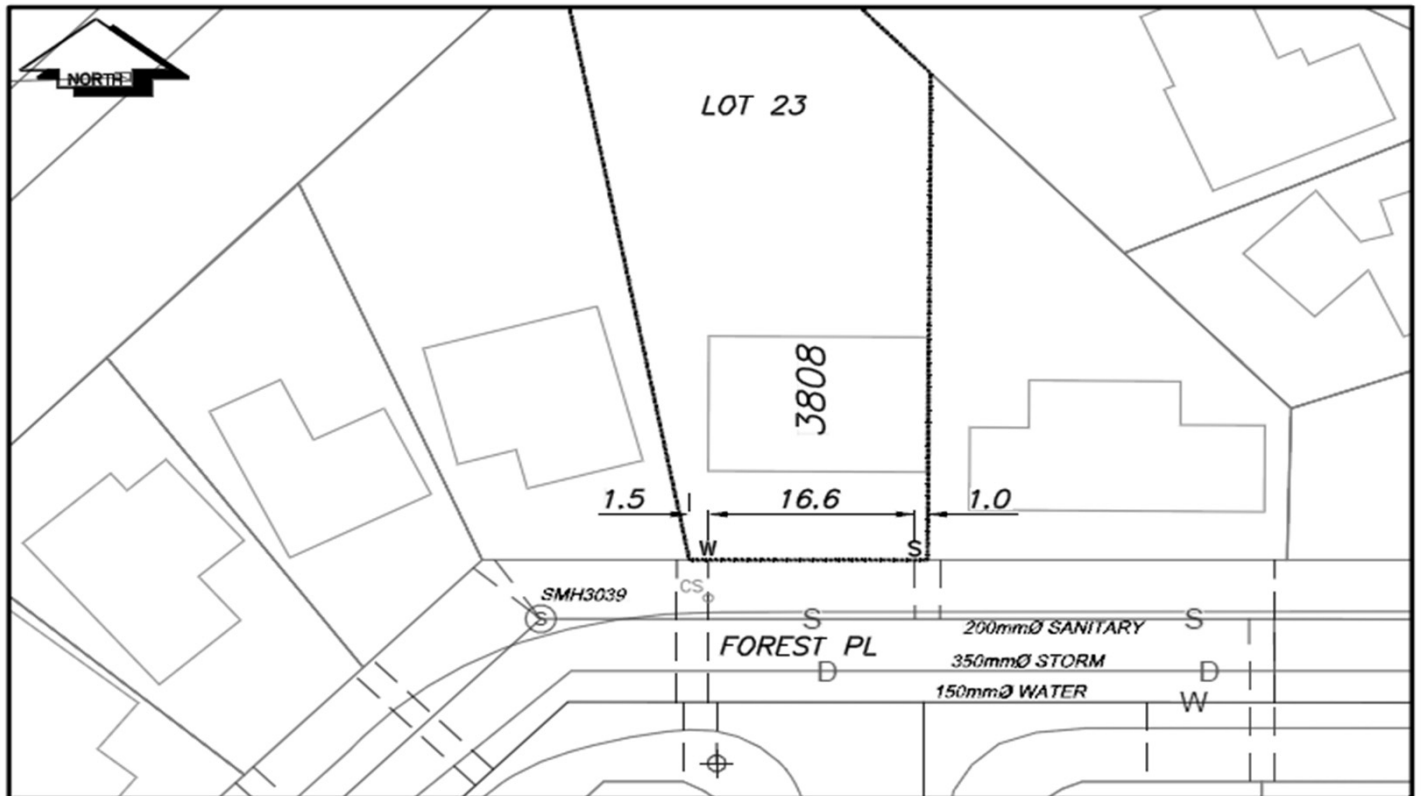

LEGEND:		
CS	CURB STOP	---W--- WATER SERVICE
CO	CLEAN OUT	---S--- SANITARY SERVICE
⊗	WATER VALVE	---D--- STORM SERVICE
		---G--- GAS
		---X--- ENCUMBRANCE
		⊕ FIRE HYDRANT

NOT TO SCALE