

City of Prince George HISTORY SHEET

SHEET NUMBER

Roll Number 008524289

Legal: LOT'S 3 BLOCK D.L. 635 PLAN 23385

Address: 1854 SOMMERVILLE RD

Sanitary Connection: # 11257 SIZE 4" MATERIAL A.C. INV. CONNECTED

Water Connection # 11257 SIZE 3/4" MATERIAL COPPER METER CONNECTED

Storm Connection: # SIZE MATERIAL INV. CONNECTED

Cash Receipt No's: WATER SANITARY 0435 STORM

CURB FROM PROPERTY LINE PAVEMENT WIDTH

B.C. HYDRO UNDERGROUND CONNECTION

B.C. TELEPHONE UNDERGROUND CONNECTION


INLAND GAS

Information Sheets:

Comments:

THE INFORMATION CONTAINED HEREIN IS FOR INTERNAL
USE ONLY. NOT TO BE RELIED UPON UNLESS CONFIRMED
BY SITE INSPECTION AND/OR INVESTIGATION.

SITE PLAN N.T.S.

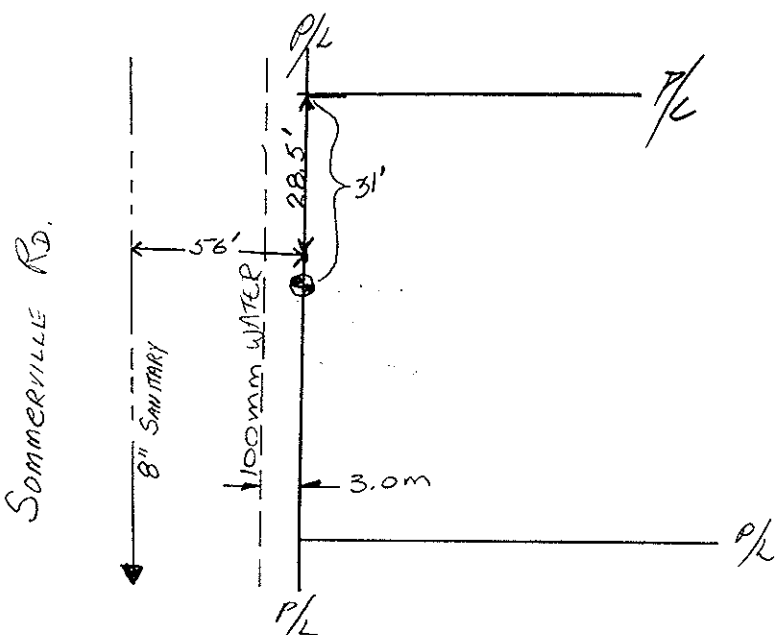

SOMMERVILLE RD.

