

**City of Prince George
HISTORY SHEET**

008-524785

SHEET NUMBER

Roll Number

Legal: LOT'S 65 BLOCK _____ D.L. 2610 PLAN 16510.

Address: 300 PORTAGE St.

Sanitary Connection: # 5514 SIZE 100mm MATERIAL A.C. INV. 603.259 CONNECTED

Water Connection # 5514 SIZE 30mm MATERIAL Cu. METER _____ CONNECTED

Storm Connection: # _____ SIZE _____ MATERIAL _____ INV. _____ CONNECTED

Cash Receipt No's: WATER _____ SANITARY _____ STORM _____

CURB FROM PROPERTY LINE 4.877m PAVEMENT WIDTH 10.363m


B.C. HYDRO U/G UNDERGROUND CONNECTION

B.C. TELEPHONE U/G UNDERGROUND CONNECTION


INLAND GAS 3.048m FROM R.

Information Sheets:

Comments:

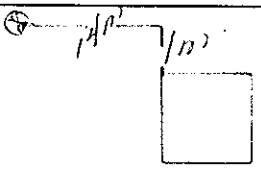

SITE PLAN N.T.S.

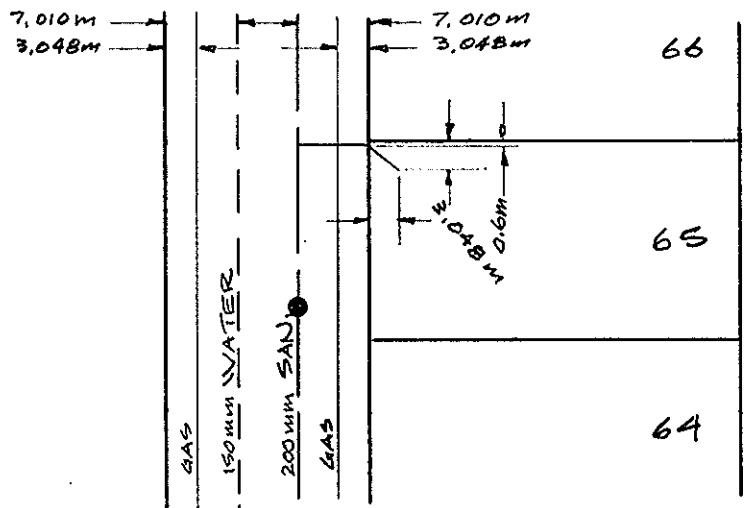

PORTAGE ST.