

# City of Prince George HISTORY SHEET

75

SHEET NUMBER **Nº 2155** Roll Number **008559457**

Legal: LOT'S **3** BLOCK **12** D.L. **1426** PLAN **23375**

Address: **2864 OAK ST.**

Sanitary Connection: # SIZE **100mm** MATERIAL **PVC** INV. **CONNECTED**

Water Connection # SIZE **20mm** MATERIAL **Copper** METER **CONNECTED**

Storm Connection: # SIZE **100mm** MATERIAL **PVC** INV. **CONNECTED**

Cash Receipt No's: WATER SANITARY STORM

CURB FROM PROPERTY LINE PAVEMENT WIDTH

A.C. HYDRO UNDERGROUND CONNECTION



B.C. TELEPHONE UNDERGROUND CONNECTION

INLAND GAS

Information Sheets:

Comments: **COMPULSORY conn. 1978**

SITE      PLAN      N.T.S.

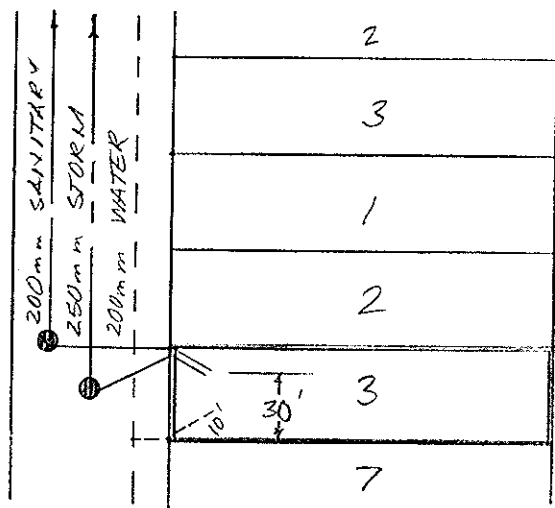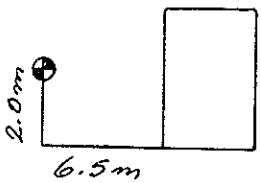

OAK ST